Suffolk Construction Company, Inc.
65 Allerton Street
Boston, Massachusetts 02119
P: (617) 445-3500
F: (617) 541-2128

Project: 226052 DFCI-BIDMC New Cancer Hospital - 1 Joslin Place - Construction
1 Joslin Place
Boston, Massachusetts 02215

RFI #0-PB-128: Clarification of Bridge Hanger and WT Size

Revision	0	**Status**	Closed on 03/16/26
To	Jessica Hoctor (Payette Associates, Inc. (BOSTON)) Emilio Cardarelli (PAYETTE) Hyunsuk Yun (Payette Associates, Inc. (BOSTON)) Jeff Abramson (Payette Associates, Inc. (BOSTON)) Jensen Ying (Payette Associates, Inc. (BOSTON)) Mollica Manandhar (Payette Associates, Inc. (BOSTON))	**From**	JP Connors (Suffolk Construction) 65 Allerton St. Boston, Massachusetts 02119
Date Initiated	Mar 3, 2026	**Due Date**	Mar 10, 2026
Location		**Project Stage**	
Cost Impact	TBD	**Schedule Impact**	TBD
Spec Section	051200 - STRUCTURAL STEEL FRAMING	**Cost Code**	
Drawing Number	S1.75	**Reference**	
Linked Drawings			
Received From	Devin DiManno (Suffolk Construction)	**Sub Job**	
Copies To	Elisa Arriaga (Vanasse Hangen Brustlin, Inc. (BOSTON)), Craig Blanchet (Lemessurier Consultants, Inc. (BOSTON)), Joy Clark (Leggat McCall Properties LLC), JP Connors (Suffolk Construction), Nathan Crowley (Suffolk Construction), Emil Giordano (Suffolk Construction), Kevin Griffin (Leggat McCall Properties LLC), Benjamin Hedges (Suffolk Construction), Emily Jacobsen (Lemessurier Consultants, Inc. (BOSTON)), Avinash Jadhav (Lemessurier Consultants, Inc. (BOSTON)), Silas Mackey (Suffolk Construction), Mithila Madhavan (Lemessurier Consultants, Inc. (BOSTON)), Kevin Malenchini (Suffolk Construction), Rick Medeiros (Suffolk Construction), Rob Morsi (Suffolk Construction), Steve Mulligan (St. Onge Company (YORK)), Christopher O'Neil (Suffolk Construction), Kaitlyn Palmer (Lemessurier Consultants, Inc. (BOSTON)), Joel Perry (Suffolk Construction), Kyle Reilly (Suffolk Construction), Henry Sniezek (Suffolk Construction) , Ben Stanton (Leggat McCall Properties LLC), Dan Sullivan (Leggat McCall Properties LLC), Sabrina Torchia (Suffolk Construction), Bob Walsh (Leggat McCall Properties LLC), Benjamin Watkins (Suffolk Construction)		

ADDITIONAL FIELDS

Required Reviewers		**Urgency**	Medium

Activity

Question

Question from JP Connors Suffolk Construction *on Tuesday, Mar 3, 2026 at 07:46 AM EST*

Please reference Detail 6/Drawing S1.75 dated 2/5/26 and the attached markup.

Please provide the sizes for the highlighted members (new hangers, WT, WF reinforcing) on the attached markup.

Attachments
RFI-0-PB-128_Clarification of Bridge Hanger and WT Size.pdf

Official Response

Response from Emilio Cardarelli PAYETTE *on Friday, Mar 13, 2026 at 02:10 PM EDT*

Please see attached response to RFI 0-PB-128

Attachments
RFI-0-PB-128_Clarification of Bridge Hanger & WT Size_PAI - Response.pdf

All Replies

Response from JP Connors Suffolk Construction *on Monday, Mar 16, 2026 at 07:27 AM EDT*

PAI 3/13/26 Response: Infrastructure scope associated with Building Connectors (Brookline Ave, Pilgrim Road, Longwood Center) was Issued for Progress with the 2/5 Addendum package. This scope, inclusive of structural renovation work within Longwood Center, will be finalized for the forthcoming Infrastructure Bulletin.

Response from Emilio Cardarelli PAYETTE *on Friday, Mar 13, 2026 at 02:10 PM EDT*

Please see attached response to RFI 0-PB-128

Attachments
RFI-0-PB-128_Clarification of Bridge Hanger & WT Size_PAI - Response.pdf

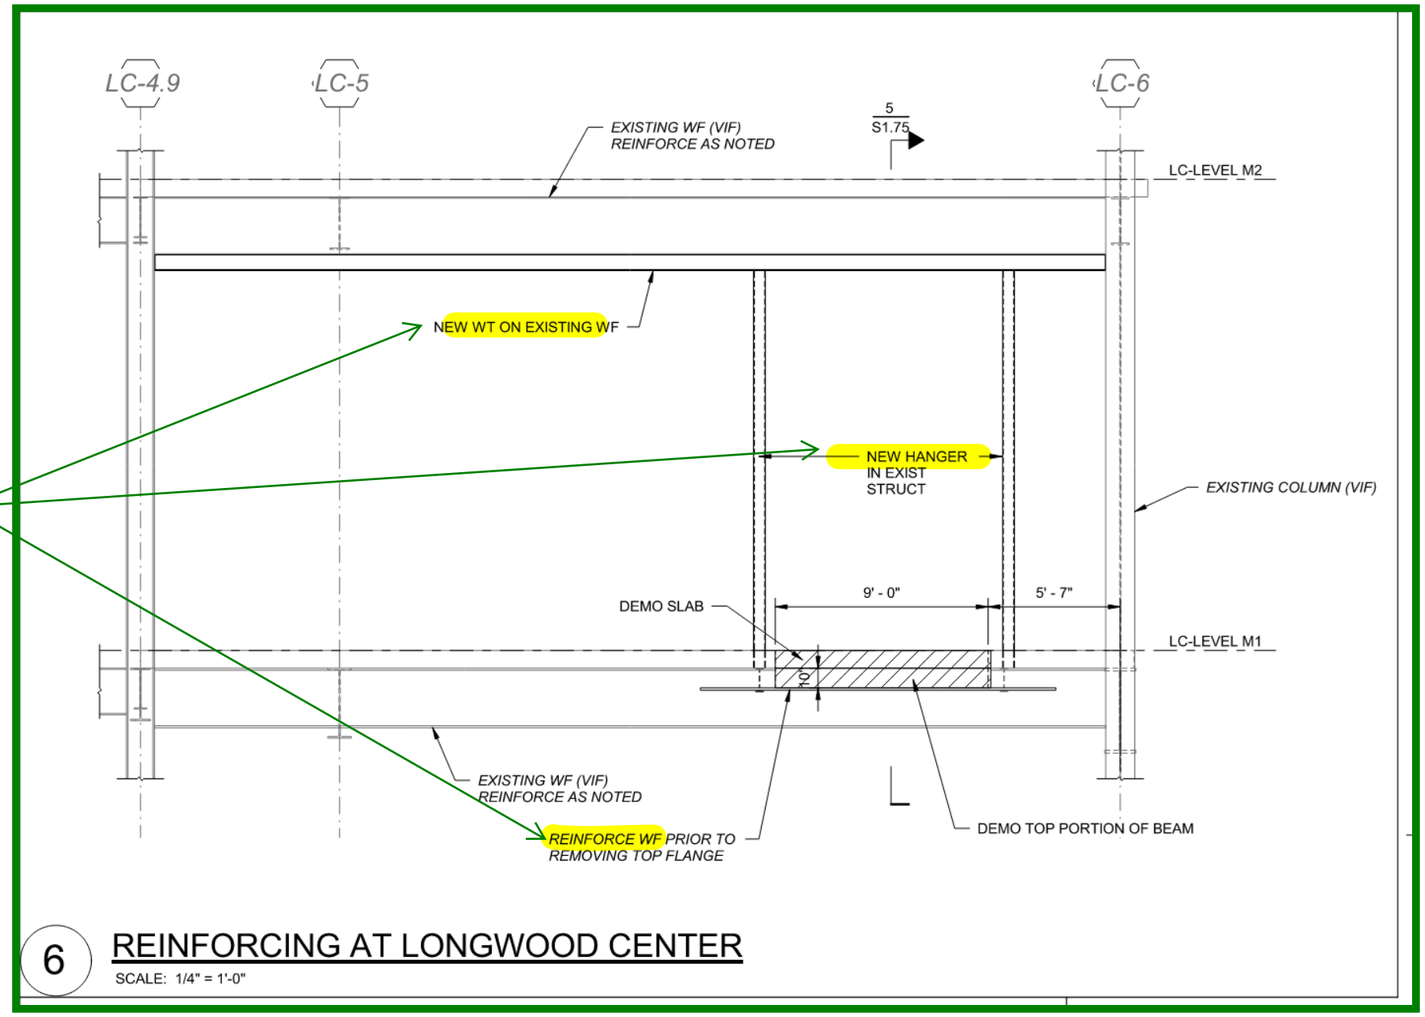

SCCI: Please provide member sizes.

Reference Drawing S1.75

SCCI Question: Please provide the sizes for the highlighted members.

SUFFOLK	Sketch: **RFI 0-PB-128**
Project: **DFCI-BIDMC New Cancer Hospital**	Date: 03/03/26
Title: **Clarification of Bridge Hanger and WT Size**	Scale: NTS

Suffolk Construction Company, Inc.
65 Allerton Street
Boston, Massachusetts 02119
P: (617) 445-3500
F: (617) 541-2128

Project: 226052 DFCI-BIDMC New Cancer Hospital - 1 Joslin Place - Construction
1 Joslin Place
Boston, Massachusetts 02215

RFI #0-PB-128: Clarification of Bridge Hanger and WT Size

Revision	0	**Status**	Open
To	Emilio Cardarelli (PAYETTE) Hyunsuk Yun (Payette Associates, Inc. (BOSTON)) Jeff Abramson (Payette Associates, Inc. (BOSTON)) Jensen Ying (Payette Associates, Inc. (BOSTON)) Jessica Hoctor (Payette Associates, Inc. (BOSTON)) Mollica Manandhar (Payette Associates, Inc. (BOSTON))	**From**	Johnpatrick Connors (Suffolk Construction) 65 Allerton St. Boston, Massachusetts 02119
Date Initiated	Mar 3, 2026	**Due Date**	Mar 10, 2026
Location		**Project Stage**	
Cost Impact	TBD	**Schedule Impact**	TBD
Spec Section	051200 - STRUCTURAL STEEL FRAMING	**Cost Code**	
Drawing Number	S1.75	**Reference**	
Linked Drawings			
Received From	Devin DiManno (Suffolk Construction)	**Sub Job**	
Copies To	Elisa Arriaga (Vanasse Hangen Brustlin, Inc. (BOSTON)), Craig Blanchet (Lemessurier Consultants, Inc. (BOSTON)), Joy Clark (Leggat McCall Properties LLC), Johnpatrick Connors (Suffolk Construction), Nathan Crowley (Suffolk Construction), Emil Giordano (Suffolk Construction), Kevin Griffin (Leggat McCall Properties LLC), Benjamin Hedges (Suffolk Construction), Emily Jacobsen (Lemessurier Consultants, Inc. (BOSTON)), Avinash Jadhav (Lemessurier Consultants, Inc. (BOSTON)), Silas Mackey (Suffolk Construction), Mithila Madhavan (Lemessurier Consultants, Inc. (BOSTON)), Kevin Malenchini (Suffolk Construction), Rick Medeiros (Suffolk Construction), Rob Morsi (Suffolk Construction), Steve Mulligan (St. Onge Company (YORK)), Christopher O'Neil (Suffolk Construction), Kaitlyn Palmer (Lemessurier Consultants, Inc. (BOSTON)), Joel Perry (Suffolk Construction), Kyle Reilly (Suffolk Construction), Henry Sniezek (Suffolk Construction) , Ben Stanton (Leggat McCall Properties LLC), Dan Sullivan (Leggat McCall Properties LLC), Sabrina Torchia (Suffolk Construction), Bob Walsh (Leggat McCall Properties LLC), Benjamin Watkins (Suffolk Construction)		

ADDITIONAL FIELDS

Required Reviewers		**Urgency**	Medium

Activity

Question

Question from Johnpatrick Connors Suffolk Construction *on Tuesday, Mar 3, 2026 at 07:46 AM EST*

Please reference Detail 6/Drawing S1.75 dated 2/5/26 and the attached markup.

Please provide the sizes for the highlighted members (new hangers, WT, WF reinforcing) on the attached markup.

Attachments
RFI-0-PB-128_Clarification of Bridge Hanger and WT Size.pdf

Awaiting an Official Response

PAYETTE Response (03.13.26):

Infrastructure scope associated with Building Connectors (Brookline Ave, Pilgrim Road, Longwood Center) was Issued for Progress with the 2/5 Addendum package. This scope, inclusive of structural renovation work within Longwood Center, will be finalized for the forthcoming Infrastructure Bulletin.

Emilio Cardarelli

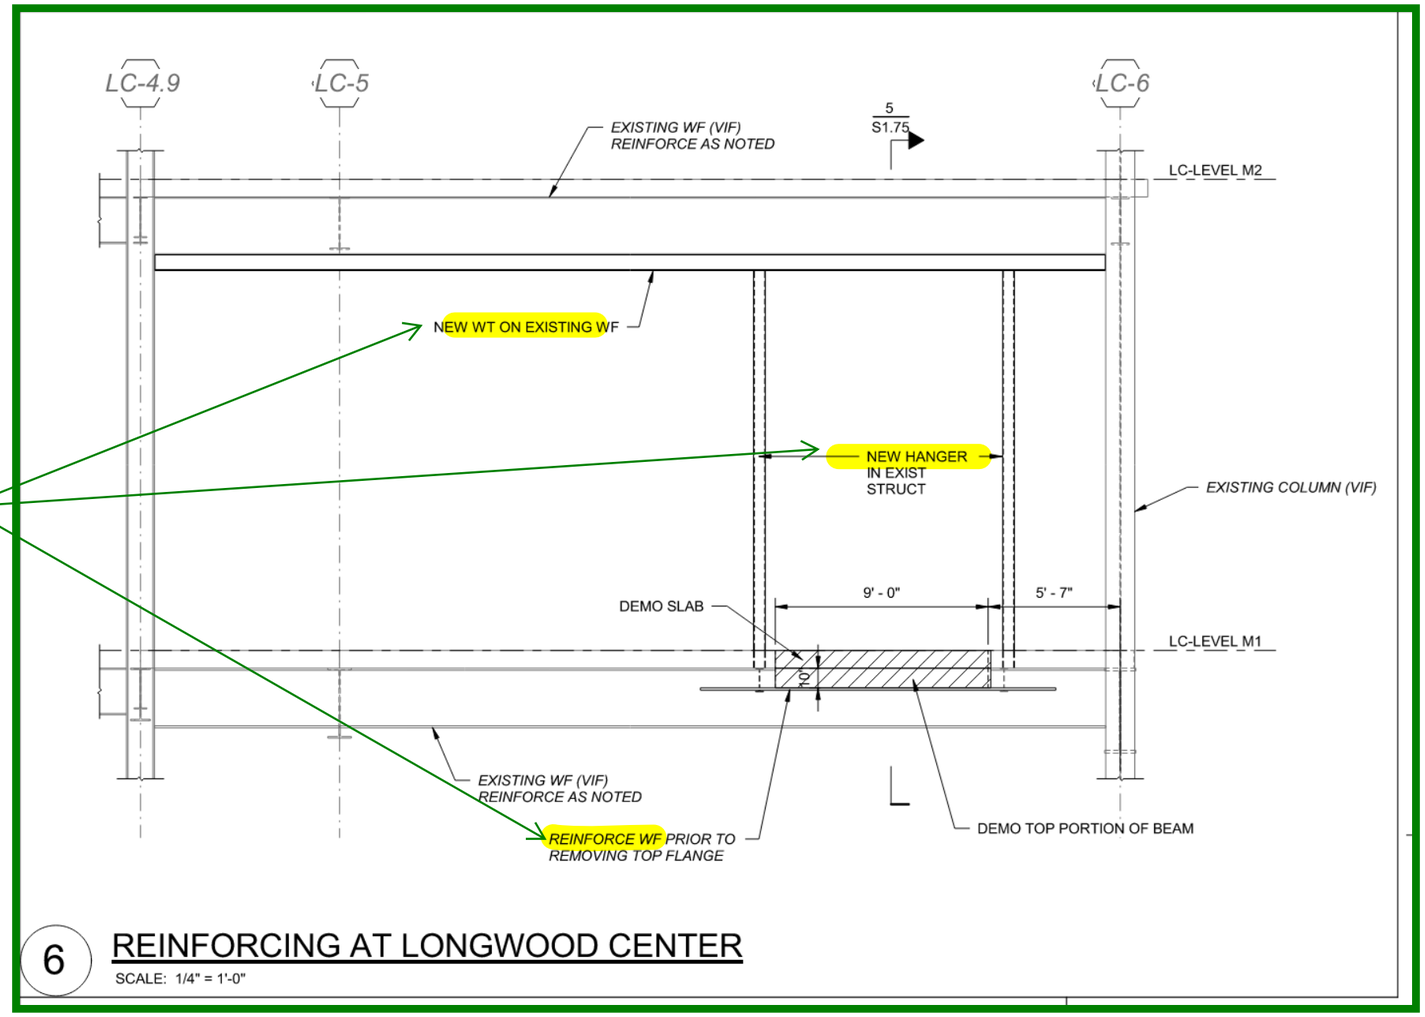

SCCI: Please provide member sizes.

Reference Drawing S1.75

SCCI Question: Please provide the sizes for the highlighted members.

SUFFOLK	Sketch: **RFI 0-PB-128**
Project: **DFCI-BIDMC New Cancer Hospital**	Date: 03/03/26
Title: **Clarification of Bridge Hanger and WT Size**	Scale: NTS