Suffolk Construction Company, Inc.
65 Allerton Street
Boston, Massachusetts 02119
P: (617) 445-3500
F: (617) 541-2128

Project: 226052 DFCI-BIDMC New Cancer Hospital - 1 Joslin Place - Construction
1 Joslin Place
Boston, Massachusetts 02215

RFI #0-PB-132: L4 Domestic Hot Water Heater Gas Connection Size

Revision	0	**Status**	Closed on 03/10/26
To	Jessica Hoctor (Payette Associates, Inc. (BOSTON)) Emilio Cardarelli (PAYETTE) Hyunsuk Yun (Payette Associates, Inc. (BOSTON)) Jeff Abramson (Payette Associates, Inc. (BOSTON)) Jensen Ying (Payette Associates, Inc. (BOSTON)) Mollica Manandhar (Payette Associates, Inc. (BOSTON))	**From**	JP Connors (Suffolk Construction) 65 Allerton St. Boston, Massachusetts 02119
Date Initiated	Mar 3, 2026	**Due Date**	Mar 10, 2026
Location		**Project Stage**	Bidding
Cost Impact	TBD	**Schedule Impact**	TBD
Spec Section	221120 - PLUMBING DISTRIBUTION PIPING	**Cost Code**	
Drawing Number	P1.04, P0.02	**Reference**	
Linked Drawings			
Received From	Benjamin Hedges (Suffolk Construction)	**Sub Job**	
Copies To	Jeff Abramson (Payette Associates, Inc. (BOSTON)), Elisa Arriaga (Vanasse Hangen Brustlin, Inc. (BOSTON)), Stephen Beck (Suffolk Construction), BR+A CA-Admin (Bard, Rao + Athanas Consulting Engineers, LLC (BOSTON)), Emilio Cardarelli (PAYETTE), Joy Clark (Leggat McCall Properties LLC), JP Connors (Suffolk Construction), Nathan Crowley (Suffolk Construction), Devin DiManno (Suffolk Construction) , Conor Driscoll (Suffolk Construction), Emil Giordano (Suffolk Construction), Kevin Griffin (Leggat McCall Properties LLC), Benjamin Hedges (Suffolk Construction), Jessica Hoctor (Payette Associates, Inc. (BOSTON)), Silas Mackey (Suffolk Construction), Kevin Malenchini (Suffolk Construction), Mollica Manandhar (Payette Associates, Inc. (BOSTON)), Rick Medeiros (Suffolk Construction), Rob Morsi (Suffolk Construction), Steve Mulligan (St. Onge Company (YORK)), Christopher O'Neil (Suffolk Construction), Joel Perry (Suffolk Construction), Kyle Reilly (Suffolk Construction), John Sanderson (Bard, Rao + Athanas Consulting Engineers, LLC (BOSTON)), Henry Sniezek (Suffolk Construction), Ben Stanton (Leggat McCall Properties LLC), Dan Sullivan (Leggat McCall Properties LLC), Sabrina Torchia (Suffolk Construction), Jake Tucci (Leggat McCall Properties LLC), Bob Walsh (Leggat McCall Properties LLC), Benjamin Watkins (Suffolk Construction), Jensen Ying (Payette Associates, Inc. (BOSTON)), Hyunsuk Yun (Payette Associates, Inc. (BOSTON))		

ADDITIONAL FIELDS

Required Reviewers		**Urgency**	Medium

Activity

Question

Question from JP Connors Suffolk Construction *on Tuesday, Mar 3, 2026 at 10:33 AM EST*

Please reference Drawing P1.04, Drawing P0.02, and the attached markup showing the gas connection to the domestic hot water heaters (DHW) on Level 4. The floor plans call for a 2 inch gas connection to the DHW whereas the schedule on Drawing P0.02 calls for a 1" gas connection. Please confirm the required gas connection size.

Attachments
RFI-0-PB-132_L4 Domestic Hot Water Heater Gas Connection Size.pdf

Official Response

Response from Emilio Cardarelli PAYETTE *on Tuesday, Mar 10, 2026 at 08:21 AM EDT*

Please see attached response from BR+A

Attachments
RFI 0-PB-132 L4 Domestic Hot Water Heater Gas Connection Size_BR+A.pdf

All Replies

Response from JP Connors Suffolk Construction *on Tuesday, Mar 10, 2026 at 10:29 AM EDT*

BR+A 3/10/26 response:

The connection size on the schedule is the required connection size on the water heater. 2"Gas supply on P1.04 is correct. Contractor shall reduce 2"supply prior to connection at water heater to match the water heater connection size.

John Sanderson BR+A March 10, 2026

Response from Emilio Cardarelli PAYETTE *on Tuesday, Mar 10, 2026 at 08:21 AM EDT*

Please see attached response from BR+A

Attachments
RFI 0-PB-132 L4 Domestic Hot Water Heater Gas Connection Size_BR+A.pdf

SCCI: Floor Plan indicates 2" gas pipe, Schedule indicates 1" gas pipe

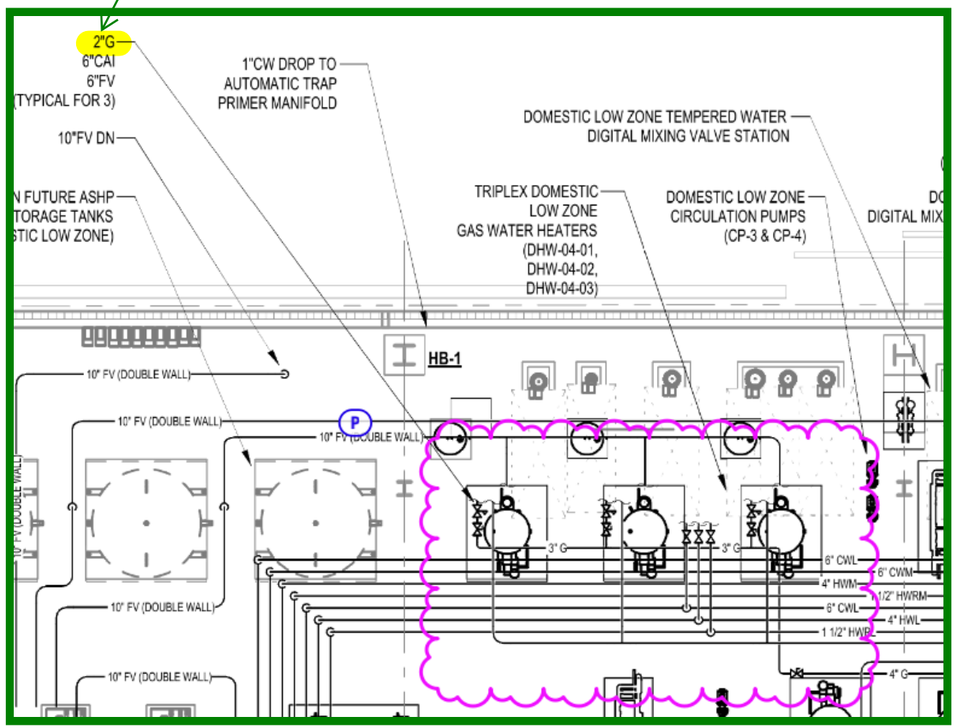

Reference Drawing P1.04

Gas Connection

DFH-M1-DHW-001	PVI	CQT 1100	HIGH ZONE, DOMESTIC, CONDENSING, SEMI-INSTATANEOUS, FIRE TUBE WATER HEATER, CONDENSATE NEUTRALIZATION SYSTEM, 6-INCH VENT	115	1,280	100	1,100,000	3.5" W.C.	1"
DFH-M1-DHW-002	PVI	CQT 1200	HIGH ZONE, DOMESTIC, CONDENSING, SEMI-INSTATANEOUS, FIRE TUBE WATER HEATER, CONDENSATE NEUTRALIZATION SYSTEM, 6-INCH VENT	100	1,280	100	1,100,000	3.5" W.C.	1"
DFH-M1-DHW-003	PVI	CQT 1200	HIGH ZONE, DOMESTIC, CONDENSING, SEMI-INSTATANEOUS, FIRE TUBE WATER HEATER, CONDENSATE NEUTRALIZATION SYSTEM, 6-INCH VENT	100	1,280	100	1,100,000	3.5" W.C.	1"

KEYNOTES:
1

Reference Drawing P0.02

SCCI Question: Please confirm the gas connection size for the domestic hot water heaters on L4.

SUFFOLK	Sketch: **RFI 0-PB-132**
Project: **DFCI-BIDMC New Cancer Hospital**	Date: 03/03/26
Title: **L4 Domestic Hot Water Heater Gas Connection Size**	Scale: NTS

Suffolk Construction Company, Inc.
65 Allerton Street
Boston, Massachusetts 02119
P: (617) 445-3500
F: (617) 541-2128

Received 03/03/2026

Project: 226052 DFCI-BIDMC New Cancer Hospital - 1 Joslin Place - Construction
1 Joslin Place
Boston, Massachusetts 02215

RFI #0-PB-132: L4 Domestic Hot Water Heater Gas Connection Size

Revision	0	**Status**	Open
To	Emilio Cardarelli (PAYETTE) Hyunsuk Yun (Payette Associates, Inc. (BOSTON)) Jeff Abramson (Payette Associates, Inc. (BOSTON)) Jensen Ying (Payette Associates, Inc. (BOSTON)) Jessica Hoctor (Payette Associates, Inc. (BOSTON)) Mollica Manandhar (Payette Associates, Inc. (BOSTON))	**From**	Johnpatrick Connors (Suffolk Construction) 65 Allerton St. Boston, Massachusetts 02119
Date Initiated	Mar 3, 2026	**Due Date**	Mar 10, 2026
Location		**Project Stage**	Bidding
Cost Impact	TBD	**Schedule Impact**	TBD
Spec Section	221120 - PLUMBING DISTRIBUTION PIPING	**Cost Code**	
Drawing Number	P1.04, P0.02	**Reference**	
Linked Drawings			
Received From	Benjamin Hedges (Suffolk Construction)	**Sub Job**	
Copies To	Jeff Abramson (Payette Associates, Inc. (BOSTON)), Elisa Arriaga (Vanasse Hangen Brustlin, Inc. (BOSTON)), Stephen Beck (Suffolk Construction), BR+A CA-Admin (Bard, Rao + Athanas Consulting Engineers, LLC (BOSTON)), Emilio Cardarelli (PAYETTE), Joy Clark (Leggat McCall Properties LLC), Johnpatrick Connors (Suffolk Construction), Nathan Crowley (Suffolk Construction), Devin DiManno (Suffolk Construction) , Conor Driscoll (Suffolk Construction), Emil Giordano (Suffolk Construction), Kevin Griffin (Leggat McCall Properties LLC), Benjamin Hedges (Suffolk Construction), Jessica Hoctor (Payette Associates, Inc. (BOSTON)), Silas Mackey (Suffolk Construction), Kevin Malenchini (Suffolk Construction), Mollica Manandhar (Payette Associates, Inc. (BOSTON)), Rick Medeiros (Suffolk Construction), Rob Morsi (Suffolk Construction), Steve Mulligan (St. Onge Company (YORK)), Christopher O'Neil (Suffolk Construction), Joel Perry (Suffolk Construction), Kyle Reilly (Suffolk Construction), John Sanderson (Bard, Rao + Athanas Consulting Engineers, LLC (BOSTON)), Henry Sniezek (Suffolk Construction), Ben Stanton (Leggat McCall Properties LLC), Dan Sullivan (Leggat McCall Properties LLC), Sabrina Torchia (Suffolk Construction), Jake Tucci (Leggat McCall Properties LLC), Bob Walsh (Leggat McCall Properties LLC), Benjamin Watkins (Suffolk Construction), Jensen Ying (Payette Associates, Inc. (BOSTON)), Hyunsuk Yun (Payette Associates, Inc. (BOSTON))		

ADDITIONAL FIELDS

Required Reviewers	**Urgency**

Activity

Question

Question from Johnpatrick Connors Suffolk Construction *on Tuesday, Mar 3, 2026 at 10:33 AM EST*

Please reference Drawing P1.04, Drawing P0.02, and the attached markup showing the gas connection to the domestic hot water heaters (DHW) on Level 4. The floor plans call for a 2 inch gas connection to the DHW whereas the schedule on Drawing P0.02 calls for a 1" gas connection. Please confirm the required gas connection size.

Attachments
RFI-0-PB-132_L4 Domestic Hot Water Heater Gas Connection Size.pdf

BR+A Response:

BR+A has reviewed the above noted description.

The connection size on the schedule is the required connection size on the water heater. 2"Gas supply on P1.04 is correct. Contractor shall reduce 2"supply prior to connection at water heater to match the water heater connection size.

John Sanderson BR+A March 10, 2026

SCCI: Floor Plan indicates 2" gas pipe, Schedule indicates 1" gas pipe

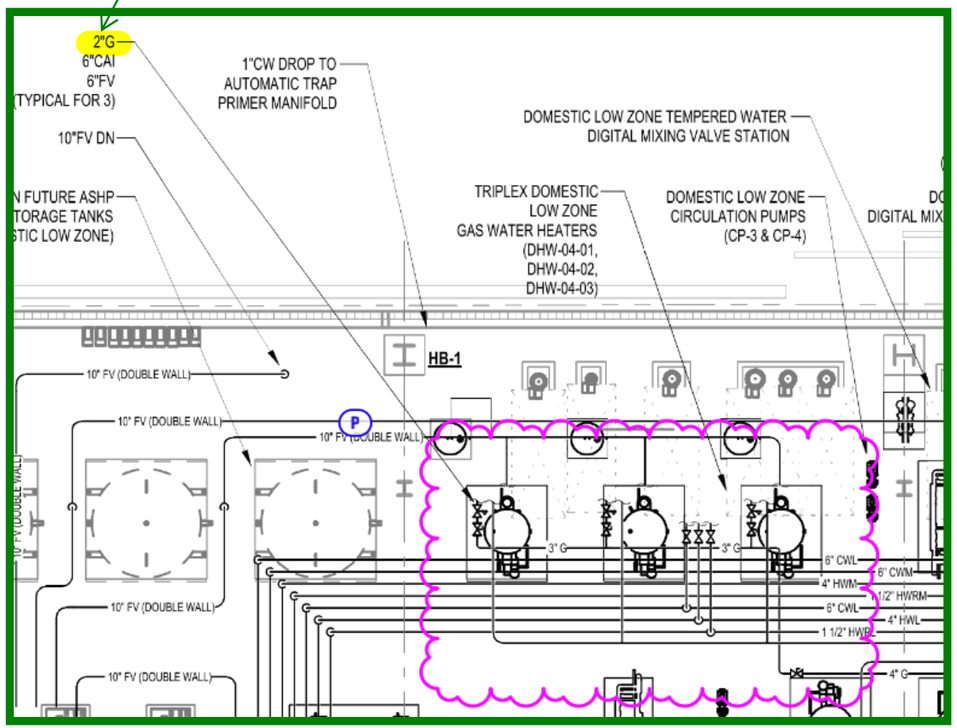

Reference Drawing P1.04

Gas Connection

DFH-M1-DHW-001	PVI	CQT 1100	HIGH ZONE, DOMESTIC, CONDENSING, SEMI-INSTATANEOUS, FIRE TUBE WATER HEATER, CONDENSATE NEUTRALIZATION SYSTEM, 6-INCH VENT	115	1,280	100	1,100,000	3.5" W.C.	1"
DFH-M1-DHW-002	PVI	CQT 1200	HIGH ZONE, DOMESTIC, CONDENSING, SEMI-INSTATANEOUS, FIRE TUBE WATER HEATER, CONDENSATE NEUTRALIZATION SYSTEM, 6-INCH VENT	100	1,280	100	1,100,000	3.5" W.C.	1"
DFH-M1-DHW-003	PVI	CQT 1200	HIGH ZONE, DOMESTIC, CONDENSING, SEMI-INSTATANEOUS, FIRE TUBE WATER HEATER, CONDENSATE NEUTRALIZATION SYSTEM, 6-INCH VENT	100	1,280	100	1,100,000	3.5" W.C.	1"

KEYNOTES:
1

Reference Drawing P0.02

SCCI Question: Please confirm the gas connection size for the domestic hot water heaters on L4.

SUFFOLK	Sketch: **RFI 0-PB-132**
Project: **DFCI-BIDMC New Cancer Hospital**	Date: 03/03/26
Title: **L4 Domestic Hot Water Heater Gas Connection Size**	Scale: NTS