Suffolk Construction Company, Inc.
65 Allerton Street
Boston, Massachusetts 02119
P: (617) 445-3500
F: (617) 541-2128

Project: 226052 DFCI-BIDMC New Cancer Hospital - 1 Joslin Place - Construction
1 Joslin Place
Boston, Massachusetts 02215

RFI #0-PB-82: C-101 Clarifications

Revision	0	**Status**	Closed on 11/24/25
To	Rob Morsi (Suffolk Construction)	**From**	Rob Morsi (Suffolk Construction) 65 Allerton St. Boston, Massachusetts 02119
Date Initiated	Nov 14, 2025	**Due Date**	Nov 21, 2025
Location		**Project Stage**	Bidding
Cost Impact		**Schedule Impact**	
Spec Section		**Cost Code**	
Drawing Number		**Reference**	Civil
Linked Drawings			
Received From		**Sub Job**	
Copies To			

ADDITIONAL FIELDS

Required Reviewers	**Urgency**

Activity

Question

Question from Rob Morsi Suffolk Construction *on Friday, Nov 14, 2025 at 03:33 PM EST*

1. Reference attached markup “C-101 RFI QUESTIONS . 11.14.25” for clarity on questions below:
    1. There are six (6) streetlight poles to be removed and stored. Will this be in the electrician’s scope?
    2. “Existing Telcom Ductbank to be relocated; contractor to confirm utility size and location prior to construction; coordination with utility provider required”
1.
    1.
        1. Will this work be done by the utility company?
        2. Where will the existing ductbank be relocated to?
        1. “Cut and Cap existing 10” chilled water services; coordinate with utility provider” – Will this work be done by the utility company?

Attachments
C-101 RFI QUESTIONS . 11.14.25.pdf

Official Response

Response from Henry Sniezek Suffolk Construction *on Monday, Nov 24, 2025 at 02:36 PM EST*

Per Payette 11/21 response: Determination of which Subcontractor's scope streetlight pole/fixture removal falls within is responsibility of the CM. Telecom ductbank information is currently in process with no firm responses. The Owner's Project Manager and CM are currently interfacing with VZ for removal/replacement. Chilled Water services will be capped by others in the Joslin Park tunnel. Contractor shall assume removal of pipes to be coordinated with utility company.

All Replies

Response from Henry Sniezek Suffolk Construction *on Monday, Nov 24, 2025 at 02:36 PM EST*

Per Payette 11/21 response: Determination of which Subcontractor's scope streetlight pole/fixture removal falls within is responsibility of the CM. Telecom ductbank information is currently in process with no firm responses. The Owner's Project Manager and CM are currently interfacing with VZ for removal/replacement. Chilled Water services will be capped by others in the Joslin Park tunnel. Contractor shall assume removal of pipes to be coordinated with utility company.

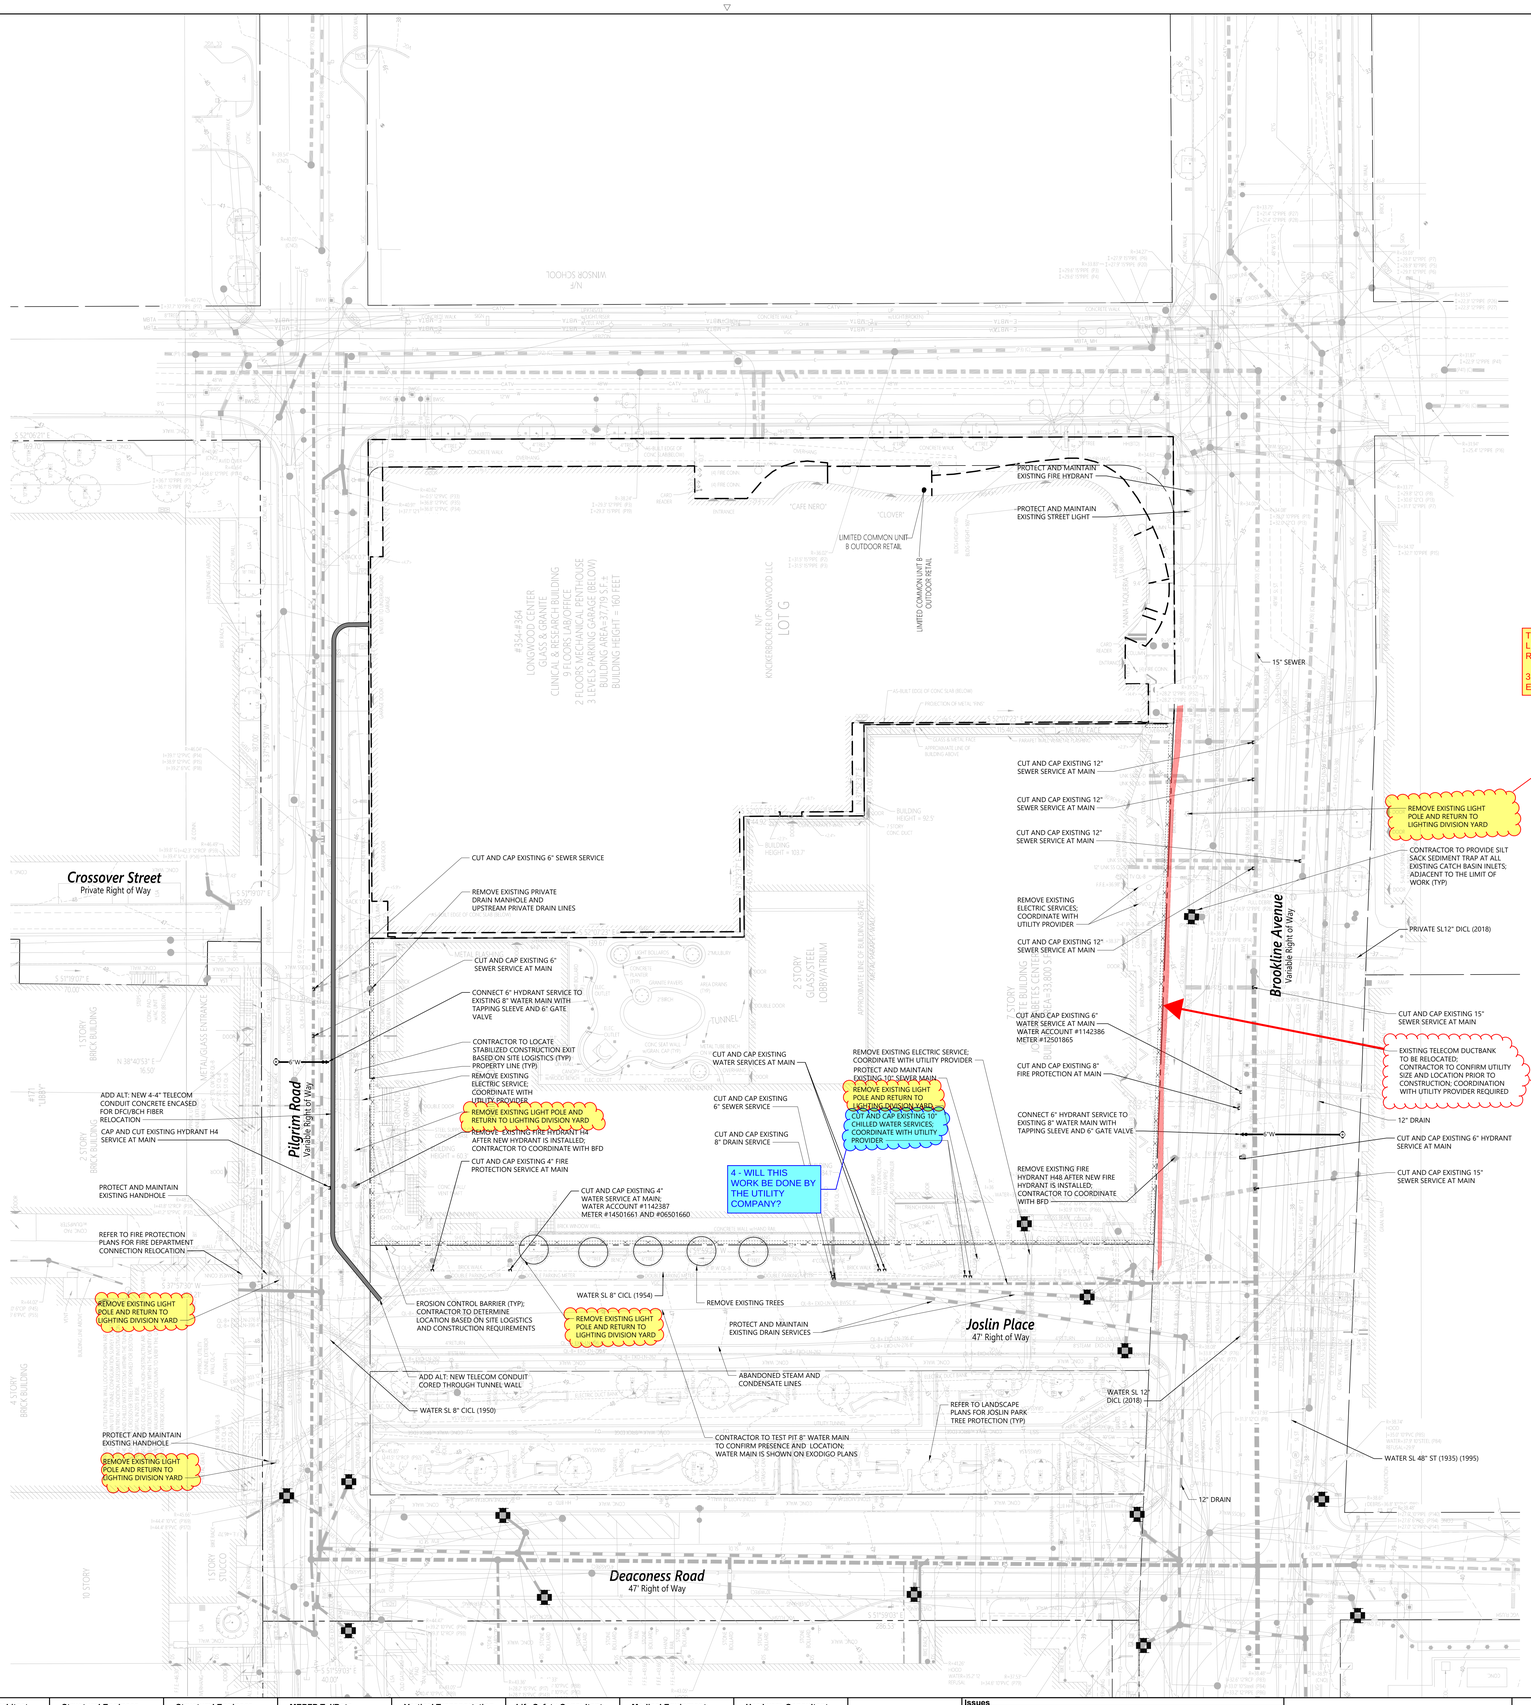

Architect
Payette Associates Inc.
290 Congress Street, Fifth Floor
Boston, MA 02210-1005
Tel: 617-895-1000
Fax: 617-895-1002

Civil and Transportation Engineer
Vanasse Hangen Brustlin, Inc.
99 High Street, 13th Flr.
Boston, MA 02110
Tel: 617-728-7777
www.vhb.com

Landscape Architect
Michael Van Valkenburgh Associates, Inc.
231 Concord Avenue
Cambridge, MA 02138
Tel: 617-864-2076
www.mvvainc.com

Structural Engineer
LeMessurier
1380 Soldiers Field Road
Boston, MA 02135
Tel: 617-868-1200
www.lemessurier.com

Structural Engineer (Dana-Mayer)
Simon Design Engineering
49 Walnut Park, Bldg. #2
Wellesley, MA 02481
Tel: 781-237-2226
www.sde-us.com

MEPFP Tel/Data Engineer and Lighting
Bard, Rao + Athanas Consulting Engineers
10 Guest Street, 4th Flr.
Boston, MA 02135
Tel: 617-254-0016
www.brplusa.com

Vertical Transportation and Materials Management
St. Onge
1400 Williams Road
York, PA 17402
Tel: 717-840-8181
www.stonge.com

Life Safety Consultant
Code Red Consultants
123 Turnpike Road, Suite 320
Southborough, MA 01772
Tel: 617-500-7633
www.coderedconsultants.com

Medical Equipment
C/W Design Group
57 Bedford Street, Suite 207
Lexington, MA 02420
Tel: 781-274-7275
www.cwdesigngroup.com

Hardware Consultant
Allegion
77 Wexford Street
Needham Heights, MA 02494
Tel: 781-453-5300
www.allegion.com

Wind/Air Entrainment Consultant
RWDI
600 Southgate Drive
Guelph, Ontario, N1G 4P6
519-823-1311
https://rwdi.com

Building Facade Consultant
Studio NYL 129
Kingston Street, Ground Floor
Boston, MA 02111
Tel: 303-558-3145
www.studionyl.com

Building Enclosure Consultant
Simpson Gumpertz & Heger
480 Totten Pond Road
Waltham, MA 02451
Tel: 781-907-9000
www.sgh.com

Parking Consultant
Walker Consultants
1075 Main St., Suite 410
Waltham, MA 02451
Tel: 617-350-5040
www.walkerconsultants.com

Acoustics Engineer
Acentech
33 Moulton Street
Cambridge, MA 02138
Tel: 617-499-8031
www.acentech.com

Food Services Consultant
Kaizen
1525 Cornwall Road
Unit 14
Oakville, ON L6J 0B2
Tel: 905-338-3222
www.kaizenfood.com

Radiation Shielding Consultant
Nelco/Trapani
2 Burlington Woods Drive, Suite 300
Burlington, MA 01803
Tel: 781-331-0429
www.nelcoworldwide.com

RF Shielding Consultant
PDC Facilities, Inc.
700 Walnut Ridge Drive
Hartland, WI 53029
Tel: 262-367-7944
www.pdcbiz.com

Issues

Number	Date	Description
00	10-30-25	FACADE AND INFRASTRUCTURE PACKAGE

Revisions

Number	Date	Description

NOT FOR CONSTRUCTION

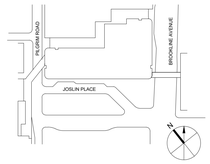

Dana-Farber Cancer Institute
Beth Israel Lahey Health
Beth Israel Deaconess Medical Center

FUTURE CANCER HOSPITAL
1 JOSLIN PLACE, BOSTON MA 02115

Site Preparation and Erosion Control Plan

Drawing Scale
1" = 20'

Project Number
16164.00

Date Issued
10/30/2025

C-101

©2025 Payette Associates Inc.