Suffolk Construction Company, Inc.
65 Allerton Street
Boston, Massachusetts 02119
P: (617) 445-3500
F: (617) 541-2128

Project: 226052 DFCI-BIDMC New Cancer Hospital - 1 Joslin Place - Construction
1 Joslin Place
Boston, Massachusetts 02215

RFI #0-PB-94: Generator Panelboard Power

Revision	0	**Status**	Closed on 12/02/25
To	Rob Morsi (Suffolk Construction) *(Response Required)*	**From**	Nathan Crowley (Suffolk Construction) 65 Allerton St. Boston, Massachusetts 02119
Date Initiated	Nov 18, 2025	**Due Date**	Dec 2, 2025
Location		**Project Stage**	Bidding
Cost Impact		**Schedule Impact**	
Spec Section		**Cost Code**	
Drawing Number	E6.05, E7.401, E7.502	**Reference**	
Linked Drawings			
Received From		**Sub Job**	
Copies To			

ADDITIONAL FIELDS

Required Reviewers	**Urgency**

Activity

Question

Question from Nathan Crowley Suffolk Construction *on Tuesday, Nov 18, 2025 at 10:50 AM EST*

The 208/120V panelboards for each of the (4) generators are to be provided with a 150A MCB per Specification 263010 Section 2.2O.1. and the E7.502 panelboard schedule. All (4) panelboards are fed by DFHM2-LS-P2, which is shown as a 150A MCB panel, however it is served by a 112.5 kVA transformer. The transformer's primary OCPD is shown as 150A via DFHM2-LS-DP4. The E7.01 transformer schedule shows 112.5 kVA transformers with 250A primary OCPD and 400A secondary OCPD. Please clarify feeder and OCPD sizes associated with power to the generator panelboards.

Attachments
Generator Panelboard Power RFI.pdf

Official Response

Response from Henry Sniezek Suffolk Construction *on Tuesday, Dec 2, 2025 at 03:45 PM EST*

Per Payette 12/2/2025 response: Panel 'DFHM2-LS-P2' shall be a 400A MCB. The primary circuit breaker in DFHM2-LS-DP4 is circuit #1 (250A) not circuit #2 (150A). Load name will be updated in the 1/15 Addendum. Generator panels shall stay as 150A with C150Y feeder tag (4#1/0 & 1#6G - 2"C).

All Replies

Response from Henry Sniezek Suffolk Construction *on Tuesday, Dec 2, 2025 at 03:45 PM EST*

Per Payette 12/2/2025 response: Panel 'DFHM2-LS-P2' shall be a 400A MCB. The primary circuit breaker in DFHM2-LS-DP4 is circuit #1 (250A) not circuit #2 (150A). Load name will be updated in the 1/15 Addendum. Generator panels shall stay as 150A with C150Y feeder tag (4#1/0 & 1#6G - 2"C).

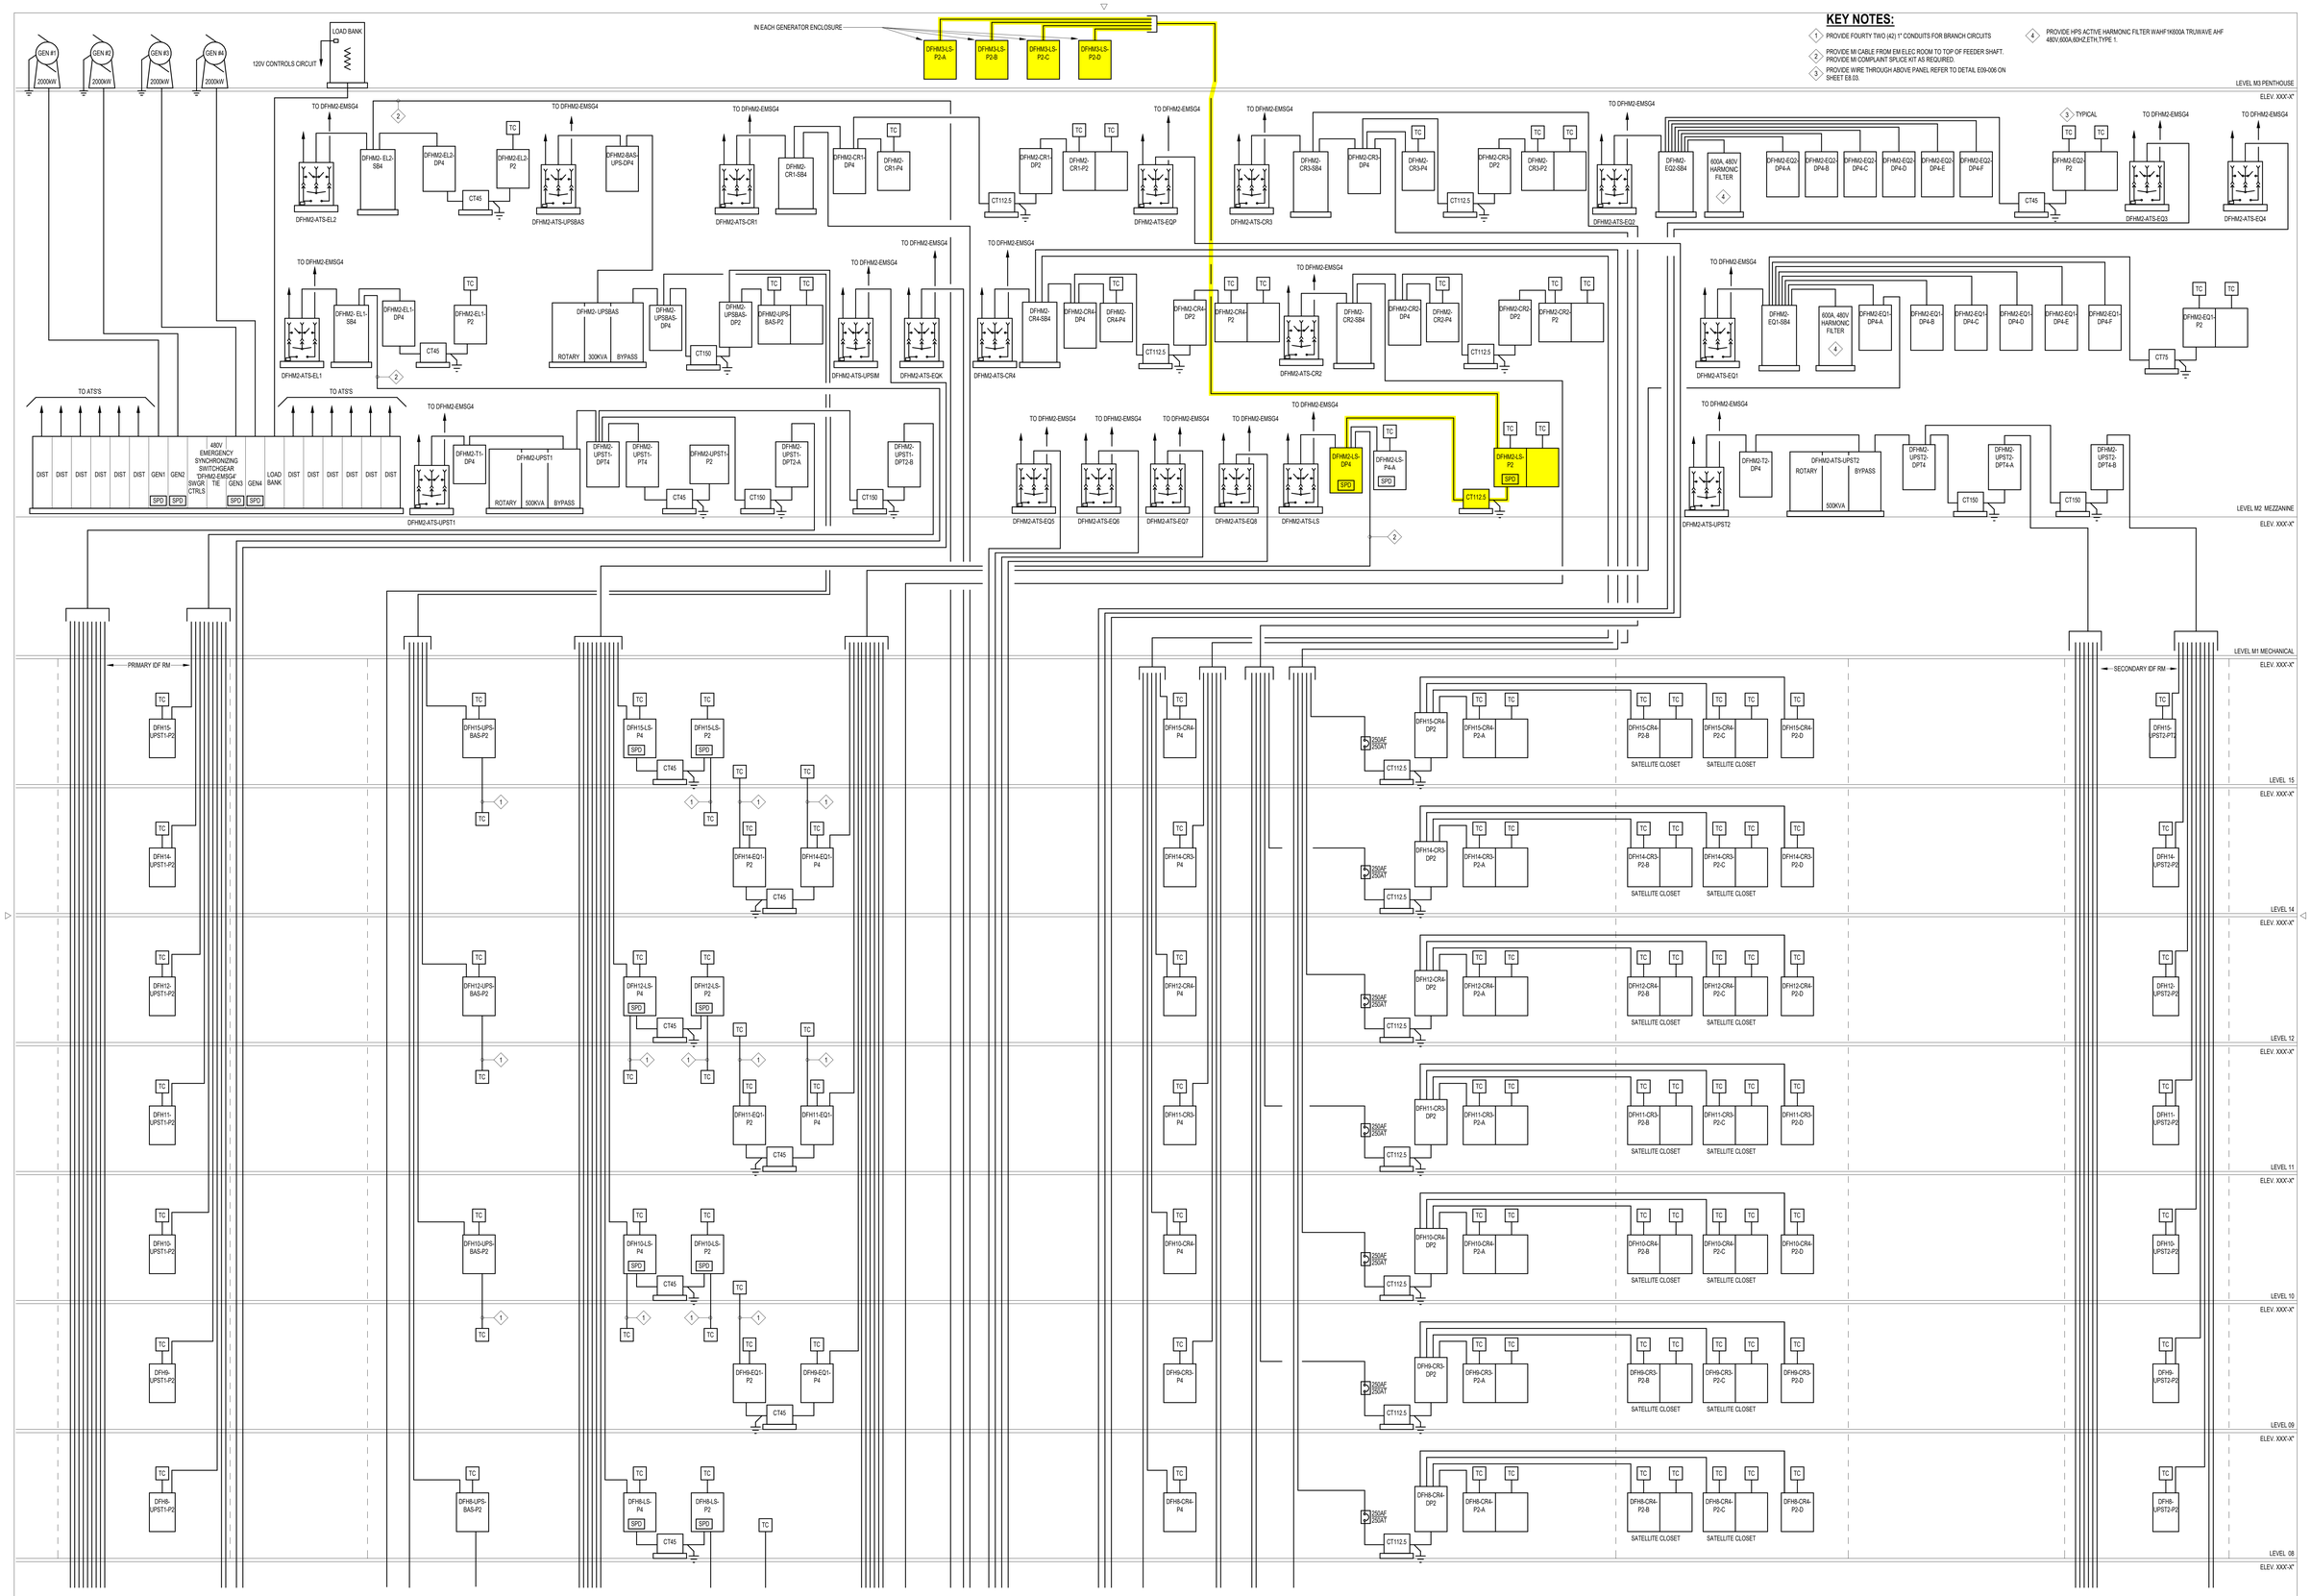

Architect

Payette Associates Inc.
290 Congress Street, Fifth Floor
Boston, MA 02210-1005
Tel: 617-895-1000
Fax: 617-895-1002

Civil and Transportation Engineer

Vanasse Hangen Brustlin, Inc.
99 High Street, 13th Flr.
Boston, MA 02110
Tel: 617-607-2971
www.vhb.com

Landscape Architect

Michael Van Valkenburgh Associates, Inc.
231 Concord Avenue
Cambridge, MA 02138
Tel: 617-864-2076
www.mvvainc.com

Structural Engineer

LeMessurier
1380 Soldiers Field Road
Boston, MA 02135
Tel: 617-868-1200
www.lemessurier.com

Structural Engineer (Dana-Mayer)

Simon Design Engineering
49 Walnut Park, Bldg. #2
Wellesley, MA 02481
Tel: 781-237-2226
www.sde-us.com

MEPFP Tel/Data Engineer and Lighting

Bard, Rao + Athanas Consulting Engineers
10 Guest Street, 4th Flr.
Boston, MA 02135
Tel: 617-254-0016
www.brplusa.com

Vertical Transportation and Materials Management

St. Onge
1400 Williams Road
York, PA 17402
Tel: 717-840-8181
www.stonge.com

Life Safety Consultant

Code Red Consultants
123 Turnpike Road, Suite 320
Southborough, MA 01772
Tel: 617-500-7633
www.coderedconsultants.com

Medical Equipment

C/W Design Group
57 Bedford Street, Suite 207
Lexington, MA 02420
Tel: 781-274-7275
www.cwdesigngroup.com

Hardware Consultant

Allegion
77 Wexford Street
Needham Heights, MA 02494
Tel: 781-453-5300
www.allegion.com

Wind/Air Entrainment Consultant

RWDI
600 Southgate Drive
Guelph, Ontario, N1G 4P6
519-823-1311
https://rwdi.com

Building Facade Consultant

Studio NYL 129
Kingston Street, Ground Floor
Boston, MA 02111
Tel: 303-558-3145
www.studionyl.com

Building Enclosure Consultant

Simpson Gumpertz & Heger
480 Totten Pond Road
Waltham, MA 02451
Tel: 781-907-9000
www.sgh.com

Parking Consultant

Walker Consultants
1075 Main St., Suite 410
Waltham, MA 02451
Tel: 617-350-5040
www.walkerconsultants.com

Acoustics Engineer

Acentech
33 Moulton Street
Cambridge, MA 02138
Tel: 617-499-8031
www.acentech.com

Food Services Consultant

Kaizen
1525 Cornwall Road
Unit 14
Oakville, ON L6J 0B2
Tel: 905-338-3222
www.kaizenfood.com

Radiation Shielding Consultant

Nelco/Trapani
2 Burlington Woods Drive, Suite 300
Burlington, MA 01803
Tel: 781-331-0429
www.nelcoworldwide.com

RF Shielding Consultant

PDC Facilities, Inc.
700 Walnut Ridge Drive
Hartland, WI 53029
Tel: 262-367-7944
www.pdcbiz.com

PAYETTE

Issues

Number	Date	Description
00	10-30-25	FACADE AND INFRASTRUCTURE PACKAGE

Revisions

Number	Date	Description

NOT FOR CONSTRUCTION

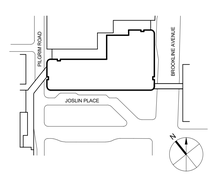

Dana-Farber Cancer Institute
Beth Israel Lahey Health
Beth Israel Deaconess Medical Center

FUTURE CANCER HOSPITAL

1 JOSLIN PLACE, BOSTON MA 02115

ELECTRICAL EMERGENCY RISER DIAGRAM #2

Drawing Scale: NONE

Project Number: 17000.00

Date Issued: 10/30/2025

E6.05

©2025 Payette Associates Inc.

Autodesk Docs://DFCI-Cancer_Hosp/17000-00-Cancer-Hospital-ELEC-R24.rvt
10/30/2025 2:52:11 PM

LEGEND OF COPPER FEEDER SIZES

NOMINAL AMPERE RATING	FEEDER TAG	CONDUCTORS (3 PHASE, 3 WIRE) WITH GROUND IN CONDUIT	CONDUCTORS (3 PHASE, 4 WIRE) WITH GROUND IN CONDUIT
60	C60Δ	3#4 & 1#10G - 1"C	4#4 & 1#10G - 1 1/4"C
	C60Y		
80	C80Δ	3#3 & 1#8G - 1 1/4"C	4#3 & 1#8G - 1 1/4"C
	C80Y		
100	C100Δ	3#1 & 1#8G - 1 1/2"C	4#1 & 1#8G - 1 1/2"C
	C100Y		
125	C125Δ	3#1/0 & 1#6G - 1 1/2"C	4#1/0 & 1#6G - 2"C
	C125Y		
150	C150Δ	3#1/0 & 1#6G - 1 1/2"C	4#1/0 & 1#6G - 2"C
	C150Y		
175	C175Δ	3#2/0 & 1#6G - 2"C	4#2/0 & 1#6G - 2"C
	C175Y		
200	C200Δ	3#3/0 & 1#6G - 2"C	4#3/0 & 1#6G - 2"C
	C200Y		
225	C225Δ	3#4/0 & 1#4G - 2"C	4#4/0 & 1#4G - 2 1/2"C
	C225Y		
250	C250Δ	3#250 KCMIL & 1#4G - 2 1/2"C	4#250 KCMIL & 1#4G - 2 1/2"C
	C250Y		
300	C300Δ	3#350 KCMIL & 1#4G - 2 1/2"C	4#350 KCMIL & 1#4G - 3"C
	C300Y		
350	C350Δ	3#500 KCMIL & 1#3G - 3"C	4#500 KCMIL & 1#3G - 3 1/2"C
	C350Y		
400	C400Δ	3#600 KCMIL & 1#3G - 3 1/2"C	4#600 KCMIL & 1#3G - 4"C
		6#250 KCMIL & 1#3G - 3"C	8#250 KCMIL & 1#3G - 3 1/2"C
	C400Y		
500	C500Δ	2 SETS OF (3#250 KCMIL & 1#2G - 2 1/2"C)	2 SETS OF (4#250 KCMIL & 1#2G - 2 1/2"C)
	C500Y		
600	C600Δ	2 SETS OF (3#350 KCMIL & 1#1G - 2 1/2"C)	2 SETS OF (4#350 KCMIL & 1#1G - 3"C)
	C600Y		
800	C800Δ	2 SETS OF (3#600 KCMIL & 1#1/0G - 3 1/2"C)	2 SETS OF (4#600 KCMIL & 1#1/0G - 4"C)
	C800Y		
1000	C1000Δ	3 SETS OF (3#400 KCMIL & 1#2/0G - 3"C)	3 SETS OF (4#400 KCMIL & 1#2/0G - 3 1/2"C)
	C1000Y		
1200	C1200Δ	3 SETS OF (3#600 KCMIL & 1#3/0G - 3 1/2"C)	3 SETS OF (4#600 KCMIL & 1#3/0G - 4"C)
	C1200Y		
1600	C1600Δ	4 SETS OF (3#600 KCMIL & 1#4/0G - 3 1/2"C)	4 SETS OF (4#600 KCMIL & 1#4/0G - 4"C)
	C1600Y		
2000	C2000Δ	5 SETS OF (3#600 KCMIL & 1#250 KCMIL G - 3 1/2"C)	5 SETS OF (4#600 KCMIL & 1#250 KCMIL G - 4"C)
	C2000Y		
2500	C2500Δ	6 SETS OF (3#600 KCMIL & 1#350 KCMIL G - 3 1/2"C)	6 SETS OF (4#600 KCMIL & 1#350 KCMIL G - 4"C)
	C2500Y		
3000	C3000Δ	8 SETS OF (3#500 KCMIL & 1#400 KCMIL G - 3 1/2"C)	8 SETS OF (4#500 KCMIL & 1#400 KCMIL G - 4"C)
	C3000Y		
3200	C3200Δ	8 SETS OF (3#600 KCMIL & 1#500 KCMIL G - 3 1/2"C)	8 SETS OF (4#600 KCMIL & 1#500 KCMIL G - 4"C)
	C3200Y		
4000	C4000Δ	10 SETS OF (3#600 KCMIL & 1#500 KCMIL G - 3 1/2"C)	10 SETS OF (4#600 KCMIL & 1#500 KCMIL G - 4"C)
	C4000Y		

LEGEND OF FEEDER SIZES NOTES:

1. ALL CONDUCTOR SIZES ARE BASED ON 2023 NEC TABLE 310.16 FOR COPPER CONDUCTORS.
2. CONDUCTORS SHALL BE PROVIDED WITH "MAC" ADAPTERS AS REQUIRED TO COORDINATE WITH BREAKER LUG SIZES.
3. CONDUCTOR TYPE SHALL BE THHN/THWN-2 OR XHHW-2 SUBJECT TO THE RESTRICTIONS OF THE NEC AND PROJECT SPECIFICATIONS.

BR+A DESIGN STANDARDS	DATE 10/25/2024	DRAWING No.

LEGEND OF EMERGENCY SYSTEM FEEDER SIZES

COPPER CONDUCTORS - MINERAL INSULATED (MI)

NOMINAL AMPERE RATING	FEEDER SYMBOL	MI CONDUCTORS (3 PHASE, 3 WIRE)	SUPPLEMENTAL MI GROUND CONDUCTOR SEE NOTE 3	CONDUCTORS IN ENCLOSURE. SEE NOTE 4	MI CONDUCTORS (3 PHASE, 4 WIRE)	SUPPLEMENTAL MI GROUND CONDUCTOR. SEE NOTE 3	CONDUCTORS IN ENCLOSURE. SEE NOTE 4	GROUND CONDUCTOR IN ENCLOSURE. SEE NOTE 5	"S" SEE NOTE 6
60	M60Δ	3#6	N/A	3#2				1#10	3/4"
	M60Y				4#6	N/A	4#2		
80	M80Δ	3#6	N/A	3#2				1#8	3/4"
	M80Y				4#6	N/A	4#2		
100	M100Δ	3#4	N/A	3#1/0				1#8	7/8"
	M100Y				4#4	N/A	4#1/0		
125	M125Δ	3#2	N/A	3#3/0				1#6	1-1/8"
	M125Y				4#2	N/A	4#3/0		
150	M150Δ	3#2	N/A	3#3/0				1#6	1-1/8"
	M150Y				4#2	N/A	4#3/0		
175	M175Δ	3#1	N/A	3#4/0				1#6	1-1/8"
	M175Y				4#1	N/A	4#4/0		
200	M200Δ	3#1/0	N/A	3#4/0				1#6	1-1/8"
	M200Y				4#1/0	N/A	4#4/0		
225	M225Δ	3#1/0	N/A	3#4/0				1#4	1-1/8"
	M225Y				4#1/0	N/A	4#4/0		
250	M250Δ	3#2/0	N/A	3#250 KCMIL				1#4	1-1/4"
	M250Y				4#2/0	N/A	4#250 KCMIL		
300	M300Δ	3#3/0	N/A	3#350 KCMIL				1#4	1-3/8"
	M300Y				4#3/0	N/A	4#350 KCMIL		
350	M350Δ	3#4/0	N/A	3#500 KCMIL				1#3	1-1/2"
	M350Y				4#4/0	N/A	4#500 KCMIL		
400	M400Δ	3#250 KCMIL	N/A	3#600 KCMIL				1#3	1-1/2"
	M400Y				4#250 KCMIL	N/A	4#600 KCMIL		
500	M500Δ	6#2/0	N/A	6#250 KCMIL				1#2	1-1/4"
	M500Y				8#2/0	N/A	8#250 KCMIL		
600	M600Δ	6#3/0	N/A	6#350 KCMIL				1#1	1-3/8"
	M600Y				8#3/0	N/A	8#350 KCMIL		
800	M800Δ	6#250 KCMIL	N/A	6#600 KCMIL				1#1/0	1-1/2"
	M800Y				8#250 KCMIL	N/A	8#600 KCMIL		
1000	M1000Δ	9#4/0	N/A	9#500 KCMIL				1#2/0	1-1/2"
	M1000Y				12#4/0	N/A	12#500 KCMIL		
1200	M1200Δ	9#250 KCMIL	N/A	9#600 KCMIL				1#3/0	1-1/2"
	M1200Y				12#250 KCMIL	N/A	12#600 KCMIL		
1600	M1600Δ	12#250 KCMIL	N/A	12#600 KCMIL				1#4/0	1-1/2"
	M1600Y				16#250 KCMIL	N/A	16#600 KCMIL		
2000	M2000Δ	15#250 KCMIL	5#6	15#600 KCMIL				1#250 KCMIL	1-1/2"
	M2000Y				20#250 KCMIL	N/A	20#600 KCMIL		
2500	M2500Δ	18#350 KCMIL	6#1	18#600 KCMIL				1#350 KCMIL	1-3/4"
	M2500Y				24#350 KCMIL	N/A	24#600 KCMIL		
3000	M3000Δ	24#250 KCMIL	8#4/0	24#500 KCMIL				1#400 KCMIL	1-1/2"
	M3000Y				32#250 KCMIL	8#1/0	32#500 KCMIL		
3200	M3200Δ	24#350 KCMIL	8#250 KCMIL	24#600 KCMIL				1#500 KCMIL	1-3/4"
	M3200Y				32#350 KCMIL	8#2/0	32#600 KCMIL		
4000	M4000Δ	30#250 KCMIL	10#250 KCMIL	30#600 KCMIL				1#500 KCMIL	1-1/2"
	M4000Y				40#250 KCMIL	10#4/0	40#600 KCMIL		

LEGEND OF EMERGENCY SYSTEM FEEDER SIZES NOTES:

1. ALL EMERGENCY SYSTEM FEEDERS SHALL BE UL LISTED AND LABELED, 2 HOUR FIRE RATED MINERAL INSULATED (MI) COPPER POWER CABLES, IN ACCORDANCE WITH NEC ARTICLE 700, AND SHALL BE INSTALLED IN ACCORDANCE WITH MANUFACTURES INSTALLATION INSTRUCTIONS TO MAINTAIN FIRE RATING.
2. ALL CONDUCTOR SIZES ARE BASED ON 2023 NEC TABLE 310.17 AND ARTICLE 332.80(B) FOR CONDUCTORS GROUPED TOGETHER IN A TRIANGULAR OR RECTANGULAR CONFIGURATION, IN FREE AIR.
3. WHERE INDICATED, PROVIDE SUPPLEMENTAL GROUNDING CONDUCTOR TO RUN WITH ASSOCIATED PHASE AND NEUTRAL CONDUCTORS. WHERE SUPPLEMENTAL GROUNDING MI CONDUCTOR PENETRATES PANEL OR OTHER ENCLOSURE, IT SHALL BE PROVIDED WITH A SIZE-TO-SIZE TERMINATION TO TRANSITION TO STRANDED CONDUCTORS. THESE CONDUCTORS SHALL LAND ON THE PANEL GROUND BUS BAR.
4. WHERE MI CONDUCTORS PENETRATE PANEL OR OTHER ENCLOSURE, THEY SHALL BE PROVIDED WITH A SIZED-UP TERMINATION TO TRANSITION TO STRANDED CONDUCTORS, SIZED IN ACCORDANCE WITH 2023 NEC TABLE 310.16. THESE CONDUCTORS SHALL LAND ON THE RESPECTIVE PANEL BUS BARS AND/OR MAIN CIRCUIT BREAKER LUGS. REFER TO SPECIFICATION SECTION 26 0530 FOR ALLOWABLE CONDUCTOR TYPES.
5. FURNISH AND INSTALL A FOOT LUG, ATTACHED TO THE BRASS PLATE HARDWARE INSIDE OF THE PANEL, RUN STRANDED GROUND CONDUCTOR FROM THE LUG TO THE GROUND BUS BAR, SIZED IN ACCORDANCE WITH 2023 NEC 250.122. REFER TO SPECIFICATION SECTION 26 0530 FOR ALLOWABLE CONDUCTOR TYPES.
6. MINIMUM DISTANCE AROUND EXTERIOR OF MI CABLE BUNDLE AND BETWEEN PARALLEL RUNS OF MI CABLE, TO MAINTAIN FREE AIR RATING IN ACCORDANCE WITH 2023 NEC 332.80(B).
7. HORIZONTAL AND VERTICAL SPACING SHALL BE SET TO MAINTAIN MANUFACTURERS UL LISTING REQUIREMENTS FOR THIS APPLICATION.

BR+A DESIGN STANDARDS	DATE 10/25/2024	DRAWING No.

DRY TYPE TRANSFORMER SCHEDULE - COPPER COILS AND FEEDERS

SIZE	kVA	PRIMARY			SECONDARY			SUPPLY SIDE BONDING JUMPER AND SYSTEM BONDING JUMPER (1)	GROUNDING ELECTRODE CONDUCTOR (2)
		AMPERES	480 VOLT OVERCURRENT PROTECTION	CONDUCTORS (3 PHASE, 3 WIRE) WITH GROUND IN CONDUIT	AMPERES	208 VOLT OVERCURRENT PROTECTION	CONDUCTORS (3 PHASE, 4 WIRE) WITH SUPPLY SIDE BONDING JUMPER IN CONDUIT		
CT9	9	11	20A, 3P	3#12 & 1#12G - 3/4"C	25	30A, 3P	4#8 & 1#8G - 1"C	1#8	1#8 - 3/4"C
CT15	15	18	30A, 3P	3#10 & 1#10G - 3/4"C	42	50A, 3P	4#6 & 1#8G - 1"C	1#8	1#8 - 3/4"C
CT30	30	36	60A, 3P	3#4 & 1#10G - 1"C	83	100A, 3P	4#1 & 1#6G - 2"C	1#6	1#6 - 3/4"C
CT45	45	54	80A, 3P	3#3 & 1#8G - 1 1/4"C	125	150A, 3P	4#1/0 & 1#6G - 2"C	1#6	1#6 - 3/4"C
CT75	75	90	150A, 3P	3#1/0 & 1#6G - 1 1/2"C	208	250A, 3P	4#250 KCMIL & 1#2G - 2 1/2"C	1#2	1#2 - 3/4"C
CT112.5	112.5	135	250A, 3P	3#250 KCMIL & 1#4G - 2 1/2"C	313	400A, 3P	4#600 KCMIL & 1#1/0G - 4"C	1#1/0	1#1/0 - 3/4"C
							8#250 KCMIL & 1#1/0G - 3 1/2"C	1#1/0	1#1/0 - 3/4"C
CT150	150	181	300A, 3P	3#350 KCMIL & 1#4G - 2 1/2"C	417	500A, 3P	2 SETS OF (4#250 KCMIL & 1#1/0G - 2 1/2"C)	1#1/0	1#1/0 - 3/4"C
CT225	225	271	400A, 3P	3#600 KCMIL & 1#3G - 3 1/2"C	625	800A, 3P	2 SETS OF (4#600 KCMIL & 1#3/0G - 4"C)	1#3/0	1#3/0 - 1"C
				6#250 KCMIL & 1#3G - 3"C					
CT300	300	361	600A, 3P	2 SETS OF (3#350 KCMIL & 1#1G - 2 1/2"C)	834	1000A, 3P	3 SETS OF (4#400 KCMIL & 1#3/0G - 3 1/2"C)	1#3/0	1#3/0 - 1"C
CT500	500	602	1000A, 3P	3 SETS OF (3#400 KCMIL & 1#2/0G - 3"C)	1390	1600A, 3P	4 SETS OF (4#600 KCMIL & 1#300 KCMIL G - 4"C)	1#300 KCMIL	1#3/0 - 1"C

DRY TYPE TRANSFORMER SCHEDULE NOTES:

1. ALL PHASE AND NEUTRAL CONDUCTOR SIZES ARE BASED ON COPPER CONDUCTORS PER 2023 NEC TABLE 310.16.
2. MANUFACTURERS SELECTION FOR THE TYPE OF PRIMARY CIRCUIT BREAKER (THERMAL MAGNETIC VS. SOLID STATE) SHALL ENSURE COORDINATION WITH TRANSFORMER IN-RUSH CURRENT. IF MIS-COORDINATION IS IDENTIFIED BY THE COORDINATION STUDY, THE MANUFACTURER SHALL REPLACE THE DEVICE WITH A DEVICE THAT WILL PROPERLY COORDINATE. AT NO ADDITIONAL COST.
3. SECONDARY OVERCURRENT PROTECTION SHALL BE LOCATED WITHIN A PANELBOARD (MAIN CIRCUIT BREAKER) OR INDIVIDUALLY MOUNTED CIRCUIT BREAKER. THE SECONDARY OVERCURRENT PROTECTION DEVICE SHALL BE LOCATED SUCH THAT THE MAXIMUM LENGTH OF SECONDARY CONDUCTORS DO NOT EXCEED 10'-0".
4. CONDUCTORS SHALL BE PROVIDED WITH "MAC" ADAPTERS AS REQUIRED TO COORDINATE WITH BREAKER LUG SIZES.
5. CONDUCTOR TYPE SHALL BE THHN/THWN-2 OR XHHW-2 SUBJECT TO THE RESTRICTIONS OF THE NEC AND PROJECT SPECIFICATIONS.

DRY TYPE TRANSFORMER KEY NOTES:

1. SIZE OF SUPPLY SIDE BONDING JUMPER AND SYSTEM BOUNDING JUMPER, PER 2023 NEC 250.102(C)(1).
2. SIZE OF GROUNDING ELECTRODE CONDUCTOR. THE GROUNDING ELECTRODE CONDUCTOR SHALL BE UNSPLICED AND RUN IN CONDUIT FROM THE NEUTRAL BUS TO THE GROUDING ELECTRODE SYSTEM, PER 2023 NEC 250.66.
3. SECONDARY EQUIPMENT GROUND BUS SHALL BE LOCATED WITHIN A PANELBOARD OR INDIVIDUALLY MOUNTED CIRCUIT BREAKER.

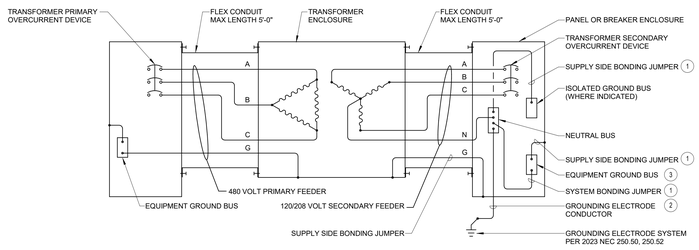

DRY TYPE TRANSFORMER WIRING DIAGRAM

BR+A DESIGN STANDARDS	DATE 05/06/2025	DRAWING No.

SPECIAL PURPOSE RECEPTACLE SCHEDULE

SYMBOL	NEMA	DESCRIPTION	HUBBELL CAT. No.	COOPER CAT. No.	BRYANT CAT. No.	P & S CAT. No.	C.B.	BRANCH CIRCUIT SEE NOTES
1	5-20R	20A - 125V, 2P, 3W	HBL5361	5361	5361	5361	20A, 1P	3#10 & 1#10G-3/4"C
2	5-30R	30A - 125V, 2P, 3W	HBL9308	5716-N	9530-FR	3802	30A, 1P	3#10 & 1#10G-3/4"C
3	5-50R	50A - 125V, 2P, 3W	HBL9360	1253	9550-FR	---	50A, 1P	2#6 & 1#10G-3/4"C
4	6-20R	20A - 250V, 2P, 3W	HBL5461	5461	5461	5871	20A, 2P	3#10 & 1#10G-3/4"C
5	6-30R	30A - 250V, 2P, 3W	HBL9330	5700-N	9630-FR	3801	30A, 2P	3#10 & 1#10G-3/4"C
6	6-50R	50A - 250V, 2P, 3W	HBL9367	5709-N	9650-FR	3804	50A, 2P	3#6 & 1#10G-3/4"C
7	14-20R	20A - 125/250V, 3P, 4W	HBL8410	5759	---	3820	20A, 2P	3#10 & 1#10G-3/4"C
8	14-30R	30A - 125/250V, 3P, 4W	HBL9430A	5744-N	9430-FR	3864	30A, 2P	3#10 & 1#10G-3/4"C
9	14-50R	50A - 125/250V, 3P, 4W	HBL9450A	5754-N	9450-FR	3894	50A, 2P	3#6 & 1#10G-1"C
10	14-60R	60A - 125/250V, 3P, 4W	HBL9460A	9460-N	9460-FR	---	60A, 2P	3#6 & 1#10G-1"C
11	15-20R	20A - 250V, 3Ø, 3P, 4W	HBL8420A	---	---	---	20A, 3P	3#12 & 1#12G-3/4"C
12	15-30R	30A - 250V, 3Ø, 3P, 4W	HBL8430A	8430-N	8430-FR	5740	30A, 3P	3#10 & 1#10G-3/4"C
13	15-50R	50A - 250V, 3Ø, 3P, 4W	HBL8450A	8450-N	8450-FR	5750	50A, 3P	3#6 & 1#10G-1"C
14	15-60R	60A - 250V, 3Ø, 3P, 4W	HBL8460A	8460-N	8460-FR	5760	60A, 3P	3#6 & 1#10G-1"C
15	L5-20R	20A - 125V, 2P, 3W, TWIST LOCK	HBL2310	CWL520R	70520-FR	L520R	20A, 1P	3#10 & 1#10G-3/4"C
16	L5-30R	30A - 125V, 2P, 3W, TWIST LOCK	HBL2610	CWL530R	70530-FR	L530R	30A, 1P	3#10 & 1#10G-3/4"C
17	L6-20R	20A - 250V, 2P, 3W, TWIST LOCK	HBL2320	CWL620R	70620-FR	L620R	20A, 2P	3#10 & 1#10G-3/4"C
18	L6-30R	30A - 250V, 2P, 3W, TWIST LOCK	HBL2620	CWL630R	70630-FR	L630R	30A, 2P	3#10 & 1#10G-3/4"C
19	L14-20R	20A - 125/250V, 3P, 4W, TWIST LOCK	---	---	---	L1420R	20A, 2P	3#10 & 1#10G-3/4"C
20	L14-30R	30A - 125/250V, 3P, 4W, TWIST LOCK	---	---	---	L1430R	30A, 2P	3#10 & 1#10G-3/4"C
21	L15-20R	20A - 250V, 3Ø, 3P, 4W, TWIST LOCK	---	---	---	L1520R	20A, 3P	3#12 & 1#12G-3/4"C
22	L15-30R	30A - 250V, 3Ø, 3P, 4W, TWIST LOCK	---	---	---	L1530R	30A, 3P	3#10 & 1#10G-3/4"C
23	L21-20R	20A - 125/250V, 3Ø, 4P, 5W, TWIST LOCK	HBL2510	---	---	L2120R	20A, 3P	4#12 & 1#12G-3/4"C

NOTES:

1. BRANCH CIRCUIT FOR DEVICE SYMBOLS 1, 2, 15 & 16 INCLUDES A SPARE PHASE CONDUCTOR FOR FUTURE USE. WITHIN THE PANEL, SPARE PHASE CONDUCTOR SHALL BE CAPPED, TY-WRAPPED TO ASSOCIATED PHASE, NEUTRAL AND GROUND CONDUCTOR, PROPERLY IDENTIFIED AND INCLUDE SUFFICIENT SLACK TO CONNECT TO CIRCUIT BREAKER IN THE FUTURE. WITHIN THE OUTLET BOX, SPARE PHASE CONDUCTOR SHALL BE CAPPED, PROPERLY IDENTIFIED AND INCLUDE SUFFICIENT SLACK TO CONNECT TO WIRING DEVICE IN THE FUTURE.
2. BRANCH CIRCUIT FOR DEVICE SYMBOLS 4, 5, 17 & 18 INCLUDES A SPARE NEUTRAL CONDUCTOR FOR FUTURE USE. WITHIN THE PANEL, SPARE NEUTRAL CONDUCTOR SHALL TERMINATE ON THE NEUTRAL BUS AND BE PROPERLY IDENTIFIED. WITHIN THE OUTLET BOX, SPARE NEUTRAL CONDUCTOR SHALL BE CAPPED, PROPERLY IDENTIFIED AND INCLUDE SUFFICIENT SLACK TO CONNECT TO WIRING DEVICE IN THE FUTURE.

MOTOR WIRING SCHEDULE

(FOR SINGLE SPEED, 480 VOLT MOTORS ONLY)

HORSE POWER	FEEDER - 480VOLT, 3Ø, 3WIRE
1/2	3#12 & 1#12G - 3/4"C.
3/4	3#12 & 1#12G - 3/4"C.
1	3#12 & 1#12G - 3/4"C.
1 1/2	3#12 & 1#12G - 3/4"C.
2	3#12 & 1#12G - 3/4"C.
3	3#12 & 1#12G - 3/4"C.
5	3#10 & 1#10G - 3/4"C.
7.5	3#10 & 1#10G - 3/4"C.
10	3#8 & 1#10G - 1"C.
15	3#8 & 1#8G - 1"C.
20	3#6 & 1#8G - 1"C.
25	3#6 & 1#8G - 1"C.
30	3#4 & 1#6G - 1 1/4"C.
40	3#3 & 1#6G - 1 1/4"C.
50	3#1 & 1#4G - 1 1/2"C.
60	3#1/0 & 1#4G - 2"C.
75	3#2/0 & 1#4G - 2"C.
100	3#3/0 & 1#3G - 2"C.
125	3#4/0 & 1#2G - 2 1/2"C.
150	3#350KCMIL & 1#1/0G - 3"C.
200	3#500KCMIL & 1#2/0G - 3 1/2"C.

MOTOR WIRING SCHEDULE

(FOR SINGLE SPEED, 208 VOLT MOTORS ONLY)

HORSE POWER	FEEDER - 208VOLT, 3Ø, 3WIRE
1/2	3#12 & 1#12G - 3/4"C.
3/4	3#12 & 1#12G - 3/4"C.
1	3#12 & 1#12G - 3/4"C.
1 1/2	3#12 & 1#12G - 3/4"C.
2	3#10 & 1#10G - 3/4"C.
3	3#10 & 1#10G - 3/4"C.
5	3#8 & 1#8G - 1"C.
7.5	3#6 & 1#8G - 1"C.
10	3#4 & 1#6G - 1 1/4"C.
15	3#3 & 1#6G - 1 1/4"C.
20	3#2 & 1#6G - 1 1/4"C.
25	3#1 & 1#4G - 1 1/2"C.
30	3#1/0 & 1#4G - 2"C.
40	3#3/0 & 1#3G - 2"C.
50	3#4/0 & 1#2G - 2 1/2"C.
60	3#300 KCMIL & 1#1G - 3"C.
75	3#500 KCMIL & 1#1/0G - 3 1/2"C.
100	3#600 KCMIL & 1#2/0G - 3 1/2"C.

BRANCH CIRCUITS SCHEDULE

CIRCUIT BREAKER	CONDUCTOR
120 or 277 VOLT 1Ø, 2W. CIRCUITS	
30A-1P	2#10 & 1#10G - 3/4"C
40A-1P	2#8 & 1#10G - 3/4"C
50A-1P	2#6 & 1#10G - 3/4"C
60A-1P	2#4 & 1#10G - 1"C
208 VOLT 1Ø, 2W. CIRCUITS	
20A-2P	2#12 & 1#12G - 3/4"C
30A-2P	2#10 & 1#10G - 3/4"C
40A-2P	2#8 & 1#10G - 3/4"C
50A-2P	2#6 & 1#10G - 3/4"C
60A-2P	2#4 & 1#10G - 1"C
120/208 VOLT 1Ø, 3W. CIRCUITS	
20A-3P	3#12 & 1#12G - 3/4"C
30A-3P	3#10 & 1#10G - 3/4"C
40A-3P	3#8 & 1#10G - 3/4"C
50A-3P	3#6 & 1#10G - 3/4"C
60A-3P	3#4 & 1#10G - 1"C
208 or 480 VOLT 3Ø, 3W. CIRCUITS	
20A-3P	3#12 & 1#12G - 3/4"C
30A-3P	3#10 & 1#10G - 3/4"C
40A-3P	3#8 & 1#10G - 3/4"C
50A-3P	3#6 & 1#10G - 3/4"C
60A-3P	3#4 & 1#10G - 1"C
208 or 480 VOLT 3Ø, 4W. CIRCUITS	
20A-3P	4#12 & 1#12G - 3/4"C
30A-3P	4#10 & 1#10G - 3/4"C
40A-3P	4#8 & 1#10G - 3/4"C
50A-3P	4#6 & 1#10G - 3/4"C
60A-3P	4#4 & 1#10G - 1 1/4"C

NOTES:
1. FOR BRANCH CIRCUITS INDICATED ON PLAN

Architect
Payette Associates Inc.
290 Congress Street, Fifth Floor
Boston, MA 02210-1005
Tel: 617-895-1000
Fax: 617-895-1002

PAYETTE

Civil and Transportation Engineer
Vanasse Hangen Brustlin, Inc.
99 High Street, 13th Flr.
Boston, MA 02110
Tel: 617-607-2971
www.vhb.com

Landscape Architect
Michael Van Valkenburgh Associates, Inc.
231 Concord Avenue
Cambridge, MA 02138
Tel: 617-864-2076
www.mvvainc.com

Structural Engineer
LeMessurier
1380 Soldiers Field Road
Boston, MA 02135
Tel: 617-868-1200
www.lemessurier.com

Structural Engineer (Dana-Mayer)
Simon Design Engineering
49 Walnut Park, Bldg. #2
Wellesley, MA 02481
Tel: 781-237-2226
www.sde-us.com

MEPFP Tel/Data Engineer and Lighting
Bard, Rao + Athanas Consulting Engineers
10 Guest Street, 4th Flr.
Boston, MA 02135
Tel: 617-254-0016
www.brplusa.com

Vertical Transportation and Materials Management
St. Onge
1400 Williams Road
York, PA 17402
Tel: 717-840-8181
www.stonge.com

Life Safety Consultant
Code Red Consultants
123 Turnpike Road, Suite 320
Southborough, MA 01772
Tel: 617-500-7633
www.coderedconsultants.com

Medical Equipment
C/W Design Group
57 Bedford Street, Suite 207
Lexington, MA 02420
Tel: 781-274-7275
www.cwdesigngroup.com

Hardware Consultant
Allegion
77 Wexford Street
Needham Heights, MA 02494
Tel: 781-453-5300
www.allegion.com

Wind/Air Entrainment Consultant
RWDI
600 Southgate Drive
Guelph, Ontario, N1G 4P6
519-823-1311
https://rwdi.com

Building Facade Consultant
Studio NYL 129
Kingston Street, Ground Floor
Boston, MA 02111
Tel: 303-558-3145
www.studionyl.com

Building Enclosure Consultant
Simpson Gumpertz & Heger
480 Totten Pond Road
Waltham, MA 02451
Tel: 781-907-9000
www.sgh.com

Parking Consultant
Walker Consultants
1075 Main St., Suite 410
Waltham, MA 02451
Tel: 617-350-5040
www.walkerconsultants.com

Acoustics Engineer
Acentech
33 Moulton Street
Cambridge, MA 02138
Tel: 617-499-8031
www.acentech.com

Food Services Consultant
Kaizen
1525 Cornwall Road
Unit 14
Oakville, ON L6J 0B2
Tel: 905-338-3222
www.kaizenfood.com

Radiation Shielding Consultant
Nelco/Trapani
2 Burlington Woods Drive, Suite 300
Burlington, MA 01803
Tel: 781-331-0429
www.nelcoworldwide.com

RF Shielding Consultant
PDC Facilities, Inc.
700 Walnut Ridge Drive
Hartland, WI 53029
Tel: 262-367-7944
www.pdcbiz.com

Issues

Number	Date	Description
.00	10-30-25	FAÇADE AND INFRASTRUCTURE PACKAGE

Revisions

Number	Date	Description

NOT FOR CONSTRUCTION

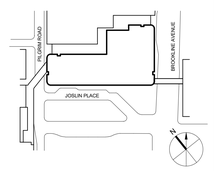

Dana-Farber Cancer Institute | Beth Israel Lahey Health | Beth Israel Deaconess Medical Center

FUTURE CANCER HOSPITAL
1 JOSLIN PLACE, BOSTON MA 02115

ELECTRICAL GENERAL SCHEDULE

Drawing Scale: 12" = 1'-0"
Project Number: 17000.00
Date Issued: 10/30/2025

E7.01

©2025 Payette Associates Inc.

Autodesk Docs://BFCA-Cancer_Hosp/17000.00-Cancer-Hospital-EL-ECI-R24.rvt
10/30/2025 2:52:19 PM

SWITCHBOARD: DFHM2-EL1- SB4

VOLTAGE: 480Y/277
PHASES: 3
WIRES: 4
AIC RATING: 100K

LOCATION:
SUPPLY FROM: DFHM2-ATS-EL1
MOUNTING: Surface
ENCLOSURE: Type 1
SPD:

POWER BRANCH: LIFE SAFETY
MAIN BUS: 1600 A
MCB TRIP: 1600A
GROUND BUS: YES
NEUTRAL BUS: 100%
ENERGY METER: NO

NOTES:

#	LOAD	OVERCURRENT BREAKER FRAME	TRIP	# OF POLES	TYPE	LOAD (KVA)	BRA FDR TAG	REMARKS
1	DFHM2-EL1- DP4	800 A	800 A	3		406.9	C800Y	
2	DFHP4-EL1- DP4	400 A	400 A	3		201.1	C400Y	
3	SPARE	800 A	800 A	3	--	0.0	--	
4	SPARE	800 A	800 A	3	--	0.0	--	
5	SPARE	400 A	400 A	3	--	0.0	--	
6	SPARE	400 A	400 A	3	--	0.0	--	
7	SPACE (800A FRAME)	--	--	3	--	--	--	
8	SPACE (800A FRAME)	--	--	3	--	--	--	

SWITCHBOARD: DFHM2-EL2- SB4

VOLTAGE: 480Y/277
PHASES: 3
WIRES: 4
AIC RATING: 100K

LOCATION:
SUPPLY FROM: DFHM2-ATS-EL2
MOUNTING: Surface
ENCLOSURE: Type 1
SPD:

POWER BRANCH: LIFE SAFETY
MAIN BUS: 1600 A
MCB TRIP: 1600A
GROUND BUS: YES
NEUTRAL BUS: 100%
ENERGY METER: NO

NOTES:

#	LOAD	OVERCURRENT BREAKER FRAME	TRIP	# OF POLES	TYPE	LOAD (KVA)	BRA FDR TAG	REMARKS
1	DFH4-EL2- DP4	800 A	800 A	3		181.7	C800Y	
2	DFHM2-EL2- DP4	800 A	800 A	3		406.9	C800Y	
3	SPARE	800 A	800 A	3	--	0.0	--	
4	SPARE	800 A	800 A	3	--	0.0	--	
5	SPARE	400 A	400 A	3	--	0.0	--	
6	SPARE	400 A	400 A	3	--	0.0	--	
7	SPACE (800A FRAME)	--	--	3	--	--	--	
8	SPACE (800A FRAME)	--	--	3	--	--	--	

DIST PANEL: DFHM2-EL1- DP4

VOLTAGE: 480Y/277
PHASES: 3
WIRES: 4
AIC RATING: 100K

LOCATION:
SUPPLY FROM: DFHM2-EL1- SB4
MOUNTING: Surface
ENCLOSURE: Type 1
SPD:

POWER BRANCH: LIFE SAFETY
MAIN BUS: 800 A
MCB TRIP: 800A
GROUND BUS: YES
NEUTRAL BUS: 100%
ENERGY METER: NO

NOTES:

#	LOAD	OVERCURRENT BREAKER FRAME	TRIP	# OF POLES	TYPE	Load	BRA FDR TAG	REMARKS
1	ELEVATOR MOTOR PT1 (1@80HP)	400 A	300 A	3		83.0	3#3/0 & 1#3G. - 2"C	
2	ELEVATOR MOTOR PT2 (1@80HP)	400 A	300 A	3		83.0	3#3/0 & 1#3G. - 2"C	
3	PANEL 'DFHPH-EL1-P2' VIA XFMR	225 A	150 A	3		0.0	REFER TO XFMR SCHEDULE	
4	ELEVATOR MOTOR PE3 (1@35HP)	125 A	125 A	3		38.2	3#3 & 1#6G. - 1 1/4"C	
5	ELEVATOR MOTOR PE4 (1@35HP)	125 A	125 A	3		38.2	3#3 & 1#6G. - 1 1/4"C	
6	ELEVATOR MOTOR S1 (1@60HP)	225 A	175 A	3		63.9	REFER TO MOTOR WIRING SCHEDULE	
7	ELEVATOR MOTOR S4 (1@60HP)	225 A	175 A	3		63.9	REFER TO MOTOR WIRING SCHEDULE	
8	ELEVATOR EQUIPMENT GROUP CONTROLLER	125 A	30 A	2		0.0	REFER TO MOTOR WIRING SCHEDULE	
9	STAIR PRESSURAIZATION HV-2A (1@7.5HP)	125 A	20 A	3		9.1	REFER TO MOTOR WIRING SCHEDULE	
10	STAIR PRESSURAIZATION HV-2A (1@7.5HP)	125 A	20 A	3		9.1	REFER TO MOTOR WIRING SCHEDULE	
11	HV-1A (1@7.5HP)	125 A	20 A	3		9.1	REFER TO MOTOR WIRING SCHEDULE	
12	HV-1A (1@7.5HP)	125 A	20 A	3		9.1	REFER TO MOTOR WIRING SCHEDULE	
13	SPARE	400 A	300 A	3	--	0.0	--	
14	SPARE	400 A	300 A	3	--	0.0	--	
15	SPARE	225 A	150 A	3	--	0.0	--	
16	SPARE	225 A	150 A	3	--	0.0	--	
17	SPARE	400 A	300 A	3	--	0.0	--	
18	SPARE	125 A	50 A	3	--	0.0	--	
19	SPARE	125 A	50 A	3	--	0.0	--	
20	SPARE	125 A	30 A	3	--	0.0	--	
21	SPACE (250A FRAME)	--	--	3	--	--	--	
22	SPACE (250A FRAME)	--	--	3	--	--	--	
23	SPACE (250A FRAME)	--	--	3	--	--	--	
24	SPACE (250A FRAME)	--	--	3	--	--	--	
25	SPACE (125A FRAME)	--	--	3	--	--	--	
26	SPACE (125A FRAME)	--	--	3	--	--	--	
27	SPACE (125A FRAME)	--	--	3	--	--	--	
28	SPACE (125A FRAME)	--	--	3	--	--	--	

DIST PANEL: DFHP4-EL1- DP4

VOLTAGE: 480Y/277
PHASES: 3
WIRES: 4
AIC RATING: 65K

LOCATION:
SUPPLY FROM: DFHM2-EL1- SB4
MOUNTING: Surface
ENCLOSURE: Type 1
SPD:

POWER BRANCH: LIFE SAFETY
MAIN BUS: 400 A
MCB TRIP: 400 A
GROUND BUS: YES
NEUTRAL BUS: 100%
ENERGY METER: NO

NOTES:

#	LOAD	OVERCURRENT BREAKER FRAME	TRIP	# OF POLES	TYPE	Load	BRA FDR TAG	REMARKS
1	PANEL 'DFHPH-EL1-P2' VIA XFMR	125 A	80 A	3		1.0	REFER TO XFMR SCHEDULE	
2	ELEVATOR MOTOR GE1 (1@25HP)	125 A	80 A	3		28.2	REFER TO MOTOR WIRING SCHEDULE	
3	ELEVATOR MOTOR GE2 (1@25HP)	125 A	80 A	3		28.2	REFER TO MOTOR WIRING SCHEDULE	
4	ELEVATOR GROUP CONTROLLER	125 A	20 A	2		0.0	REFER TO MOTOR WIRING SCHEDULE	
5	SE-1 (1@20HP)	125 A	60 A	3		22.4	REFER TO MOTOR WIRING SCHEDULE	
6	SE-3 (1@20HP)	125 A	60 A	3		22.4	REFER TO MOTOR WIRING SCHEDULE	
7	SP-1 (1@10HP)	125 A	30 A	3		11.6	REFER TO MOTOR WIRING SCHEDULE	
8	SP-3 (1@10HP)	125 A	30 A	3		11.6	REFER TO MOTOR WIRING SCHEDULE	
9	IAC-1 (1@15HP)	125 A	50 A	3		18.3	REFER TO MOTOR WIRING SCHEDULE	
10	IAC-2 (1@15HP)	125 A	50 A	3		18.3	REFER TO MOTOR WIRING SCHEDULE	
11	LVP-1 (2@1.5HP)	125 A	20 A	3		5.0	REFER TO MOTOR WIRING SCHEDULE	
12	SE-1 (1@20HP)	125 A	60 A	3		22.4	REFER TO MOTOR WIRING SCHEDULE	
13	SP-1 (1@10HP)	125 A	30 A	3		11.6	REFER TO MOTOR WIRING SCHEDULE	
14	SPARE	125 A	60 A	3	--	0.0	--	
15	SPARE	125 A	50 A	3	--	0.0	--	
16	SPARE	125 A	30 A	3	--	0.0	--	
17	SPARE	125 A	30 A	3	--	0.0	--	
18	SPARE	125 A	20 A	3	--	0.0	--	
19	SPACE (125A FRAME)	--	--	3	--	--	--	
20	SPACE (125A FRAME)	--	--	3	--	--	--	
21	SPACE (125A FRAME)	--	--	3	--	--	--	
22	SPACE (125A FRAME)	--	--	3	--	--	--	
23	SPACE (125A FRAME)	--	--	3	--	--	--	
24	SPACE (125A FRAME)	--	--	3	--	--	--	
25	SPACE (125A FRAME)	--	--	3	--	--	--	
26	SPACE (125A FRAME)	--	--	3	--	--	--	
27	SPACE (125A FRAME)	--	--	3	--	--	--	
28	SPACE (125A FRAME)	--	--	3	--	--	--	

KEY NOTE

1. TRANSITION TO MI CABLE FOR AREA OUTSIDE OF 2HR RATED ROOMS AND SHAFTS

DIST PANEL: DFHM2-LS- DP4

VOLTAGE: 480Y/277
PHASES: 3
WIRES: 4
AIC RATING: 100K

LOCATION:
SUPPLY FROM: DFHM2-ATS-LS
MOUNTING: Surface
ENCLOSURE: Type 1
SPD: YES

POWER BRANCH: LIFE SAFETY
MAIN BUS: 1200 A
MCB TRIP: 1200 A
GROUND BUS: YES
NEUTRAL BUS: 100%
ENERGY METER: NO

NOTES:

#	LOAD	OVERCURRENT BREAKER FRAME	TRIP	# OF POLES	TYPE	Load	BRA FDR TAG	REMARKS
1	BRANCH PANEL 'LSP2PH' VIA XFMR	250 A	250 A	3		8.5	REFER TO XFMR SCHEDULE	
2	DFHM2-LS- P4-A	250 A	150 A	3		0.0	C150Y	
3	DFH15-LS- P4	250 A	150 A	3		4.0	C150Y	
4	DFH12-LS- P4	250 A	150 A	3		4.0	C150Y	
5	DFH10-LS- P4	250 A	150 A	3		4.0	C150Y	
6	DFH8-LS- P4	250 A	150 A	3		4.0	C150Y	
7	DFH6-LS- P4	250 A	150 A	3		4.0	C150Y	
8	DFH4-LS- P4	250 A	150 A	3		6.0	C150Y	
9	DFH2-LS- P4	250 A	150 A	3		10.8	C150Y	
10	DFH1-LS-P4	250 A	150 A	3		13.6	C150Y	
11	DFHP1-LS- P4	250 A	150 A	3		0.0	C150Y	
12	DFHP3-LS- P4	250 A	150 A	3		23.4	C150Y	
13	SPARE	125 A	80 A	3	--	0.0	--	
14	SPARE	250 A	150 A	3	--	0.0	--	
15	SPARE	250 A	150 A	3	--	0.0	--	
16	SPARE	250 A	150 A	3	--	0.0	--	
17	SPARE	250 A	150 A	3	--	0.0	--	
18	SPARE	250 A	150 A	3	--	0.0	--	
19	SPACE (250A FRAME)	--	--	3	--	--	--	
20	SPACE (250A FRAME)	--	--	3	--	--	--	
21	SPACE (250A FRAME)	--	--	3	--	--	--	
22	SPACE (250A FRAME)	--	--	3	--	--	--	
23	SPACE (250A FRAME)	--	--	3	--	--	--	
24	SPACE (250A FRAME)	--	--	3	--	--	--	
25	SPACE (125A FRAME)	--	--	3	--	--	--	
26	SPACE (125A FRAME)	--	--	3	--	--	--	
27	SPACE (125A FRAME)	--	--	3	--	--	--	
28	SPACE (125A FRAME)	--	--	3	--	--	--	

DIST PANEL: DFHM2-EL2- DP4

VOLTAGE: 480Y/277
PHASES: 3
WIRES: 4
AIC RATING: 100K

LOCATION:
SUPPLY FROM: DFHM2-EL2- SB4
MOUNTING: Surface
ENCLOSURE: Type 1
SPD:

POWER BRANCH: LIFE SAFETY
MAIN BUS: 800 A
MCB TRIP: 800A
GROUND BUS: YES
NEUTRAL BUS: 100%
ENERGY METER: NO

NOTES:

#	LOAD	OVERCURRENT BREAKER FRAME	TRIP	# OF POLES	TYPE	Load	BRA FDR TAG	REMARKS
1	ELEVATOR MOTOR PT3 (1@80HP)	400 A	300 A	3		83.0	3#3/0 & 1#3G. - 2"C	
2	ELEVATOR MOTOR PT4 (1@80HP)	400 A	300 A	3		83.0	3#3/0 & 1#3G. - 2"C	
3	PANEL 'DFHPH-EL2-P2' VIA XFMR	125 A	80 A	3		0.0	REFER TO XFMR SCHEDULE	
4	ELEVATOR MOTOR S2 (1@60HP)	225 A	175 A	3		63.9	REFER TO MOTOR WIRING SCHEDULE	
5	ELEVATOR MOTOR S3 (1@60HP)	225 A	175 A	3		63.9	REFER TO MOTOR WIRING SCHEDULE	
6	ELEVATOR MOTOR PE1 (1@35HP)	125 A	125 A	3		38.2	3#3 & 1#6G. - 1 1/4"C	
7	ELEVATOR MOTOR PE2 (1@35HP)	125 A	125 A	3		38.2	3#3 & 1#6G. - 1 1/4"C	
8	ELEVATOR GROUP CONTROLLER	125 A	30 A	2		0.0	3#4 & 1#10G - 1"C	
9	ELEVATOR GROUP CONTROLLER S2 &S1	125 A	30 A	2		0.0	3#4 & 1#10G - 1"C	
10	HV-1A (1@7.5HP)	125 A	20 A	3		9.1	REFER TO MOTOR WIRING SCHEDULE	
11	HV-1A (1@7.5HP)	125 A	20 A	3		9.1	REFER TO MOTOR WIRING SCHEDULE	
12	STAIR PRESSURAIZATION HV-2A (1@7.5HP)	125 A	20 A	3		9.1	REFER TO MOTOR WIRING SCHEDULE	
13	STAIR PRESSURAIZATION HV-2A (1@7.5HP)	125 A	20 A	3		9.1	REFER TO MOTOR WIRING SCHEDULE	
14	ELEV P1&P2 GROUP CONTROLLER	125 A	20 A	2		0.0	REFER TO MOTOR WIRING SCHEDULE	
15	SPARE	400 A	300 A	3	--	0.0	--	
16	SPARE	225 A	150 A	3	--	0.0	--	
17	SPARE	225 A	150 A	3	--	0.0	--	
18	SPARE	125 A	50 A	3	--	0.0	--	
19	SPARE	125 A	50 A	3	--	0.0	--	
20	SPARE	125 A	30 A	3	--	0.0	--	
21	SPACE (250A FRAME)	--	--	3	--	--	--	
22	SPACE (250A FRAME)	--	--	3	--	--	--	
23	SPACE (250A FRAME)	--	--	3	--	--	--	
24	SPACE (250A FRAME)	--	--	3	--	--	--	
25	SPACE (125A FRAME)	--	--	3	--	--	--	
26	SPACE (125A FRAME)	--	--	3	--	--	--	
27	SPACE (125A FRAME)	--	--	3	--	--	--	
28	SPACE (125A FRAME)	--	--	3	--	--	--	

DIST PANEL: DFH4-EL2- DP4

VOLTAGE: 480Y/277
PHASES: 3
WIRES: 4
AIC RATING: 65K

LOCATION:
SUPPLY FROM: DFHM2-EL2- SB4
MOUNTING: Surface
ENCLOSURE: Type 1
SPD:

POWER BRANCH: LIFE SAFETY
MAIN BUS: 400 A
MCB TRIP: 400A
GROUND BUS: YES
NEUTRAL BUS: 100%
ENERGY METER: NO

NOTES:

#	LOAD	OVERCURRENT BREAKER FRAME	TRIP	# OF POLES	TYPE	Load	BRA FDR TAG	REMARKS
1	HV-1B STAIR PRESSURIZATION (1@7.5HP)	125 A	20 A	3		9.1	REFER TO MOTOR WIRING SCHEDULE	
2	HV-1B STAIR PRESSURIZATION (1@7.5HP)	125 A	20 A	3		9.1	REFER TO MOTOR WIRING SCHEDULE	
3	HV-1B STAIR PRESSURIZATION (1@7.5HP)	125 A	20 A	3		9.1	REFER TO MOTOR WIRING SCHEDULE	
4	HV-1B STAIR PRESSURIZATION (1@7.5HP)	125 A	20 A	3		9.1	REFER TO MOTOR WIRING SCHEDULE	
5	HV-2B STAIR PRESSURIZATION (1@7.5HP)	125 A	20 A	3		9.1	REFER TO MOTOR WIRING SCHEDULE	
6	HV-2B STAIR PRESSURIZATION (1@7.5HP)	125 A	20 A	3		9.1	REFER TO MOTOR WIRING SCHEDULE	
7	HV-2B STAIR PRESSURIZATION (1@7.5HP)	125 A	20 A	3		9.1	REFER TO MOTOR WIRING SCHEDULE	
8	HV-2B STAIR PRESSURIZATION (1@7.5HP)	125 A	20 A	3		9.1	REFER TO MOTOR WIRING SCHEDULE	
9	MAC-1 (1@10HP)	125 A	100 A	3		34.9	REFER TO MOTOR WIRING SCHEDULE	
10	MVP-1 (1@10HP)	125 A	100 A	3		34.9	REFER TO MOTOR WIRING SCHEDULE	
11	EAC-1 (1@7.5HP)	125 A	20 A	3		9.1	REFER TO MOTOR WIRING SCHEDULE	
12	EAC-1 (1@7.5HP)	125 A	20 A	3		9.1	REFER TO MOTOR WIRING SCHEDULE	
13	HEP-2 (2@3HP)	125 A	20 A	3		6.0	REFER TO MOTOR WIRING SCHEDULE	
14	HV-3 STAIR PRESSURIZATION (1@5HP)	125 A	20 A	3		6.3	REFER TO MOTOR WIRING SCHEDULE	
15	HV-3 STAIR PRESSURIZATION (1@5HP)	125 A	20 A	3		6.3	REFER TO MOTOR WIRING SCHEDULE	
16	SPARE	125 A	30 A	3	--	0.0	--	
17	SPARE	125 A	30 A	3	--	0.0	--	
18	SPARE	125 A	20 A	3	--	0.0	--	
19	SPARE	125 A	20 A	3	--	0.0	--	
20	SPARE	125 A	20 A	3	--	0.0	--	
21	SPACE (125A FRAME)	--	--	3	--	--	--	
22	SPACE (125A FRAME)	--	--	3	--	--	--	
23	SPACE (125A FRAME)	--	--	3	--	--	--	
24	SPACE (125A FRAME)	--	--	3	--	--	--	
25	SPACE (125A FRAME)	--	--	3	--	--	--	
26	SPACE (125A FRAME)	--	--	3	--	--	--	
27	SPACE (125A FRAME)	--	--	3	--	--	--	
28	SPACE (125A FRAME)	--	--	3	--	--	--	

1. PROVIDE TRIP UNIT METER

EL1SB4PH	EL1DP4PH	EL1DP4P4
EL2SB4PH	EL2DP4PH	EL2DP44
LSDP4PH		

Architect
Payette Associates Inc.
290 Congress Street, Fifth Floor
Boston, MA 02210-1005
Tel: 617-895-1000
Fax: 617-895-1002

PAYETTE

Civil and Transportation Engineer
Vanasse Hangen Brustlin, Inc.
99 High Street, 13th Flr.
Boston, MA 02110
Tel: 617-607-2971
www.vhb.com

Landscape Architect
Michael Van Valkenburgh Associates, Inc.
231 Concord Avenue
Cambridge, MA 02138
Tel: 617-864-2076
www.mvvainc.com

Structural Engineer
LeMessurier
1380 Soldiers Field Road
Boston, MA 02135
Tel: 617-868-1200
www.lemessurier.com

Structural Engineer (Dana-Mayer)
Simon Design Engineering
49 Walnut Park, Bldg. #2
Wellesley, MA 02481
Tel: 781-237-2226
www.sde-us.com

MEPFP Tel/Data Engineer and Lighting
Bard, Rao + Athanas Consulting Engineers
10 Guest Street, 4th Flr.
Boston, MA 02135
Tel: 617-254-0016
www.brplusa.com

Vertical Transportation and Materials Management
St. Onge
1400 Williams Road
York, PA 17402
Tel: 717-840-8181
www.stonge.com

Life Safety Consultant
Code Red Consultants
123 Turnpike Road, Suite 320
Southborough, MA 01772
Tel: 617-500-7633
www.coderedconsultants.com

Medical Equipment
C/W Design Group
57 Bedford Street, Suite 207
Lexington, MA 02420
Tel: 781-274-7275
www.cwdesigngroup.com

Hardware Consultant
Allegion
77 Wexford Street
Needham Heights, MA 02494
Tel: 781-453-5300
www.allegion.com

Wind/Air Entrainment Consultant
RWDI
600 Southgate Drive
Guelph, Ontario, N1G 4P6
519-823-1311
https://rwdi.com

Building Facade Consultant
Studio NYL 129
Kingston Street, Ground Floor
Boston, MA 02111
Tel: 303-558-3145
www.studionyl.com

Building Enclosure Consultant
Simpson Gumpertz & Heger
480 Totten Pond Road
Waltham, MA 02451
Tel: 781-907-9000
www.sgh.com

Parking Consultant
Walker Consultants
1075 Main St., Suite 410
Waltham, MA 02451
Tel: 617-350-5040
www.walkerconsultants.com

Acoustics Engineer
Acentech
33 Moulton Street
Cambridge, MA 02138
Tel: 617-499-8031
www.acentech.com

Food Services Consultant
Kaizen
1525 Cornwall Road
Unit 14
Oakville, ON L6J 0B2
Tel: 905-338-3222
www.kaizenfood.com

Radiation Shielding Consultant
Nelco/Trapani
2 Burlington Woods Drive, Suite 300
Burlington, MA 01803
Tel: 781-331-0429
www.nelcoworldwide.com

RF Shielding Consultant
PDC Facilities, Inc.
700 Walnut Ridge Drive
Hartland, WI 53029
Tel: 262-367-7944
www.pdcbiz.com

Issues

Number	Date	Description
00	10-30-25	FAÇADE AND INFRASTRUCTURE PACKAGE

Revisions

Number	Date	Description

NOT FOR CONSTRUCTION

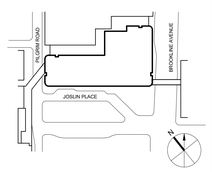

Dana-Farber Cancer Institute | Beth Israel Lahey Health | Beth Israel Deaconess Medical Center

FUTURE CANCER HOSPITAL
1 JOSLIN PLACE, BOSTON MA 02115

Drawing Scale 1/8" = 1'-0"
Project Number 17000.00
Date Issued 10/30/2025

ELECTRICAL DISTRIBUTION SCHEDULE #1

E7.401

©2025 Payette Associates Inc.

Autodesk Docs://DFCI-Cancer_Hosp/17000.00-Cancer-Hospital-ELEC-E23.rvt
10/30/2025 2:52:40 PM

SCHEDULE OF PANELBOARDS (CRITICAL)

(208/120V, 3 PHASE, 4 WIRE)

PANEL	MAINS MCB	MAINS MLO	MOUNTING	C.B. IC	TOTAL POLES	1 POLE 20A	1 POLE 30A	1 POLE 40A	1 POLE 50A	1 POLE 60A	2 POLE 20A	2 POLE 30A	2 POLE 40A	2 POLE 50A	2 POLE 60A	3 POLE 20A	3 POLE 30A	3 POLE 40A	3 POLE 100A	3 POLE 150A	SPACE 1P	SPACE 3P	NOTES
DFHM2-CR1-P2	225A		SURFACE	22KAIC	84	84																	
DFHM2-CR2-P2	225A		SURFACE	22KAIC	84	84																	
DFHM2-CR3-P2	225A		SURFACE	22KAIC	84	84																	
DFHM2-CR4-P2	225A		SURFACE	22KAIC	84	84																	
DFH15-CR4-P2-A	225A		SURFACE	22KAIC	84	84																	
DFH15-CR4-P2-B	225A		SURFACE	22KAIC	84	84																	
DFH15-CR4-P2-C	225A		SURFACE	22KAIC	84	84																	
DFH15-CR4-P2-D	225A		SURFACE	22KAIC	42	42																	
DFH14-CR3-P2-A	225A		SURFACE	22KAIC	84	84																	
DFH14-CR3-P2-B	225A		SURFACE	22KAIC	84	84																	
DFH14-CR3-P2-C	225A		SURFACE	22KAIC	84	84																	
DFH14-CR3-P2-D	225A		SURFACE	22KAIC	42	42																	
DFH12-CR4-P2-A	225A		SURFACE	22KAIC	84	84																	
DFH12-CR4-P2-B	225A		SURFACE	22KAIC	84	84																	
DFH12-CR4-P2-C	225A		SURFACE	22KAIC	84	84																	
DFH12-CR4-P2-D	225A		SURFACE	22KAIC	42	42																	
DFH11-CR3-P2-A	225A		SURFACE	22KAIC	84	84																	
DFH11-CR3-P2-B	225A		SURFACE	22KAIC	84	84																	
DFH11-CR3-P2-C	225A		SURFACE	22KAIC	84	84																	
DFH11-CR3-P2-D	225A		SURFACE	22KAIC	42	42																	
DFH10-CR4-P2-A	225A		SURFACE	22KAIC	84	84																	
DFH10-CR4-P2-B	225A		SURFACE	22KAIC	84	84																	
DFH10-CR4-P2-C	225A		SURFACE	22KAIC	84	84																	
DFH10-CR4-P2-D	225A		SURFACE	22KAIC	42	42																	
DFH9-CR3-P2-A	225A		SURFACE	22KAIC	84	84																	
DFH9-CR3-P2-B	225A		SURFACE	22KAIC	84	84																	
DFH9-CR3-P2-C	225A		SURFACE	22KAIC	84	84																	
DFH9-CR3-P2-D	225A		SURFACE	22KAIC	42	42																	
DFH8-CR4-P2-A	225A		SURFACE	22KAIC	84	84																	
DFH8-CR4-P2-B	225A		SURFACE	22KAIC	84	84																	
DFH8-CR4-P2-C	225A		SURFACE	22KAIC	84	84																	
DFH8-CR4-P2-D	225A		SURFACE	22KAIC	42	42																	
DFH7-CR3-P2-A	225A		SURFACE	22KAIC	84	84																	
DFH7-CR3-P2-B	225A		SURFACE	22KAIC	84	84																	
DFH7-CR3-P2-C	225A		SURFACE	22KAIC	84	84																	
DFH7-CR3-P2-D	225A		SURFACE	22KAIC	42	42																	
DFH6-CR4-P2-A	225A		SURFACE	22KAIC	84	84																	
DFH6-CR4-P2-B	225A		SURFACE	22KAIC	84	84																	
DFH6-CR4-P2-C	225A		SURFACE	22KAIC	84	84																	
DFH6-CR4-P2-D	225A		SURFACE	22KAIC	42	42																	
DFH5-CR3-P2-A	225A		SURFACE	22KAIC	84	84																	
DFH5-CR3-P2-B	225A		SURFACE	22KAIC	84	84																	
DFH5-CR3-P2-C	225A		SURFACE	22KAIC	84	84																	
DFH5-CR3-P2-D	225A		SURFACE	22KAIC	84	84																	
DFH5-CR3-P2-E	225A		SURFACE	22KAIC	42	42																	
DFH5-CR3-P2-F	225A		SURFACE	22KAIC	42	42																	
DFH3-CR1-P2-A	225A		SURFACE	22KAIC	84	84																	
DFH3-CR1-P2-B	225A		SURFACE	22KAIC	84	84																	
DFH3-CR1-P2-C	225A		SURFACE	22KAIC	84	84																	
DFH3-CR1-P2-D	225A		SURFACE	22KAIC	84	84																	
DFH2-CR1-P2-A	225A		SURFACE	22KAIC	84	84																	
DFH1-CR2-P2	225A		SURFACE	22KAIC	84	84																	
DFHP2-CR2-P2-A	225A		SURFACE	22KAIC	84	84																	
DFHP2-CR2-P2-B	225A		SURFACE	22KAIC	84	84																	
DFHP2-CR2-P2-C	225A		SURFACE	22KAIC	84	84																	

SCHEDULE OF PANELBOARDS (ELEVATOR)

(208/120V, 3 PHASE, 4 WIRE)

PANEL	MAINS MCB	MAINS MLO	MOUNTING	C.B. IC	TOTAL POLES	1 POLE 20A	1 POLE 30A	1 POLE 40A	1 POLE 50A	1 POLE 60A	2 POLE 20A	2 POLE 30A	2 POLE 40A	2 POLE 50A	2 POLE 60A	3 POLE 20A	3 POLE 30A	3 POLE 40A	3 POLE 80A	3 POLE 150A	SPACE 1P	SPACE 3P	NOTES
DFHM2-EL1-P2	150A		SURFACE	22KAIC	42														1				
DFHM2-EL2-P2	150A		SURFACE	22KAIC	42																		
DFHP4-EL1-P2	150A		SURFACE	22KAIC	42														1				

SCHEDULE OF PANELBOARDS (INFORMATION TECHNOLOGY & BAS)

(208/120V, 3 PHASE, 4 WIRE)

PANEL	MAINS MCB	MAINS MLO	MOUNTING	C.B. IC	TOTAL POLES	1 POLE 20A	1 POLE 30A	1 POLE 40A	1 POLE 50A	1 POLE 60A	2 POLE 20A	2 POLE 30A	2 POLE 40A	2 POLE 50A	2 POLE 60A	3 POLE 20A	3 POLE 30A	3 POLE 40A	3 POLE 100A	3 POLE 150A	SPACE 1P	SPACE 3P	NOTES
DFHM2-UPST1-PT2	225A		SURFACE	22KAIC	42	42																	
DFH15-UPST1-PT2	225A		SURFACE	22KAIC	42	42																	
DFH14-UPST1-PT2	225A		SURFACE	22KAIC	42	42																	
DFH12-UPST1-PT2	225A		SURFACE	22KAIC	42	42																	
DFH11-UPST1-PT2	225A		SURFACE	22KAIC	42	42																	
DFH10-UPST1-PT2	225A		SURFACE	22KAIC	42	42																	
DFH9-UPST1-PT2	225A		SURFACE	22KAIC	42	42																	
DFH8-UPST1-PT2	225A		SURFACE	22KAIC	42	42																	
DFH7-UPST1-PT2	225A		SURFACE	22KAIC	42	42																	
DFH6-UPST1-PT2	225A		SURFACE	22KAIC	42	42																	
DFH5-UPST1-PT2	225A		SURFACE	22KAIC	42	42																	
DFH4-UPST1-PT2	225A		SURFACE	22KAIC	42	42																	
DFH3-UPST1-PT2	225A		SURFACE	22KAIC	42	42																	
DFH2-UPST1-PT2	225A		SURFACE	22KAIC	42	42																	
DFH1-UPST1-PT2	225A		SURFACE	22KAIC	42	42																	
DFHP1-UPST1-PT2	225A		SURFACE	22KAIC	42	42																	
DFHP2-UPST1-PT2	225A		SURFACE	22KAIC	42	42																	
DFHP3-UPST1-PT2	225A		SURFACE	22KAIC	42	42																	
DFHP4-UPST1-PT2	225A		SURFACE	22KAIC	42	42																	
DFHM2-UPST2-PT2	225A		SURFACE	22KAIC	42	42																	
DFH15-UPST2-PT2	225A		SURFACE	22KAIC	42	42																	
DFH14-UPST2-PT2	225A		SURFACE	22KAIC	42	42																	
DFH12-UPST2-PT2	225A		SURFACE	22KAIC	42	42																	
DFH11-UPST2-PT2	225A		SURFACE	22KAIC	42	42																	
DFH10-UPST2-PT2	225A		SURFACE	22KAIC	42	42																	
DFH9-UPST2-PT2	225A		SURFACE	22KAIC	42	42																	
DFH8-UPST2-PT2	225A		SURFACE	22KAIC	42	42																	
DFH7-UPST2-PT2	225A		SURFACE	22KAIC	42	42																	
DFH6-UPST2-PT2	225A		SURFACE	22KAIC	42	42																	
DFH5-UPST2-PT2	225A		SURFACE	22KAIC	42	42																	
DFH4-UPST2-PT2	225A		SURFACE	22KAIC	42	42																	
DFH3-UPST2-PT2	225A		SURFACE	22KAIC	42	42																	
DFHP1-UPST2-PT2-A	225A		SURFACE	22KAIC	42	42																	
DFHP1-UPST2-PT2-B	225A		SURFACE	22KAIC	42	42																	
DFHP2-UPST2-PT2	225A		SURFACE	22KAIC	42	42																	
DFH3-UPSIM-P2	150A		SURFACE	22KAIC	42	42																	
DFHP2-UPSIM-P2	150A		SURFACE	22KAIC	42	42																	
DFHM2-UPSBAS-P2	150A		SURFACE	22KAIC	42	42																	
DFH15-UPSBAS-P2	150A		SURFACE	22KAIC	42	42																	
DFH12-UPSBAS-P2	150A		SURFACE	22KAIC	42	42																	
DFH10-UPSBAS-P2	150A		SURFACE	22KAIC	42	42																	
DFH8-UPSBAS-P2	150A		SURFACE	22KAIC	42	42																	
DFH6-UPSBAS-P2	150A		SURFACE	22KAIC	42	42																	
DFH4-UPSBAS-P2	150A		SURFACE	22KAIC	42	42																	
DFH1-UPSBAS-P2	150A		SURFACE	22KAIC	42	42																	
DFHP2-UPSBAS-P2	150A		SURFACE	22KAIC	42	42																	
DFHP4-UPSBAS-P2	150A		SURFACE	22KAIC	42	42																	

SCHEDULE OF PANELBOARDS (INFORMATION TECHNOLOGY & BAS)

(208/120V, 3 PHASE, 4 WIRE)

PANEL	MAINS MCB	MAINS MLO	MOUNTING	C.B. IC	TOTAL POLES	1 POLE 20A	1 POLE 30A	1 POLE 40A	1 POLE 50A	1 POLE 60A	2 POLE 20A	2 POLE 30A	2 POLE 40A	2 POLE 50A	2 POLE 60A	3 POLE 20A	3 POLE 30A	3 POLE 40A	3 POLE 100A	3 POLE 150A	SPACE 1P	SPACE 3P	NOTES
DFHM2-UPST1-PT4	225A		SURFACE	22KAIC	42	42																	

SCHEDULE OF PANELBOARDS (EQUIPMENT)

(208/120V, 3 PHASE, 4 WIRE)

PANEL	MAINS MCB	MAINS MLO	MOUNTING	C.B. IC	TOTAL POLES	1 POLE 20A	1 POLE 30A	1 POLE 40A	1 POLE 50A	1 POLE 60A	2 POLE 20A	2 POLE 30A	2 POLE 40A	2 POLE 50A	2 POLE 60A	3 POLE 20A	3 POLE 30A	3 POLE 40A	3 POLE 100A	3 POLE 150A	SPACE 1P	SPACE 3P	NOTES
DFHM2-EQ1-P2	225A		SURFACE	22KAIC	84																		
DFHM2-EQ2-P2	150A		SURFACE	22KAIC	84																		
DFH14-EQ1-P2	150A		SURFACE	22KAIC	42																		
DFH11-EQ1-P2	150A		SURFACE	22KAIC	42																		
DFH9-EQ1-P2	150A		SURFACE	22KAIC	42																		
DFH7-EQ1-P2	150A		SURFACE	22KAIC	42																		
DFH5-EQ1-P2	150A		SURFACE	22KAIC	42																		
DFH3-EQ1-P2	150A		SURFACE	22KAIC	42																		
DFH1-EQ1-P2	150A		SURFACE	22KAIC	42																		
DFHP2-EQ1-P2	150A		SURFACE	22KAIC	42																		
DFHP4-EQ1-P2	150A		SURFACE	22KAIC	42																		
DFH4-EQP-P2	225A		SURFACE	22KAIC	84																		
DFH2-EQK-P2-A	225A		SURFACE	22KAIC	84																		
DFH2-EQK-P2-B	225A		SURFACE	22KAIC	84																		
DFH4-EQ3-P2	225A		SURFACE	22KAIC	84																		
DFH4-EQ4-P2	150A		SURFACE	22KAIC	84																		
DFHP1-EQ3-P2	250A		SURFACE	22KAIC	84																		
DFHP1-EQ4-P2	225A		SURFACE	22KAIC	84																		

SCHEDULE OF PANELBOARDS (CRITICAL)

(480/277V, 3 PHASE, 4 WIRE)

PANEL	MAINS MCB	MAINS MLO	MOUNTING	C.B. IC	TOTAL POLES	1 POLE 20A	1 POLE 30A	1 POLE 40A	1 POLE 50A	1 POLE 60A	2 POLE 20A	2 POLE 30A	2 POLE 40A	2 POLE 50A	2 POLE 60A	3 POLE 20A	3 POLE 30A	3 POLE 40A	3 POLE 100A	3 POLE 150A	SPACE 1P	SPACE 3P	NOTES
DFHM2-CR1-P4	225A		SURFACE	65KAIC	42	42																	
DFHM2-CR2-P4	225A		SURFACE	65KAIC	42	42																	
DFHM2-CR3-P2	225A		SURFACE	65KAIC	42	42																	
DFHM2-CR4-P2	225A		SURFACE	65KAIC	42	42																	
DFH15-CR4-P4	225A		SURFACE	65KAIC	42	42																	
DFH12-CR4-P4	225A		SURFACE	65KAIC	42	42																	
DFH10-CR4-P4	225A		SURFACE	65KAIC	42	42																	
DFH8-CR4-P4	225A		SURFACE	65KAIC	42	42																	
DFH6-CR4-P4	225A		SURFACE	65KAIC	42	42																	
DFH14-CR3-P4	225A		SURFACE	65KAIC	42	42																	
DFH11-CR3-P4	225A		SURFACE	65KAIC	42	42																	
DFH9-CR3-P4	225A		SURFACE	65KAIC	42	42																	
DFH7-CR3-P4	225A		SURFACE	65KAIC	42	42																	
DFH5-CR3-P4	225A		SURFACE	65KAIC	42	42																	

SCHEDULE OF PANELBOARDS (EQUIPMENT)

(480/277V, 3 PHASE, 4 WIRE)

PANEL	MAINS MCB	MAINS MLO	MOUNTING	C.B. IC	TOTAL POLES	1 POLE 20A	1 POLE 30A	1 POLE 40A	1 POLE 50A	1 POLE 60A	2 POLE 20A	2 POLE 30A	2 POLE 40A	2 POLE 50A	2 POLE 60A	3 POLE 20A	3 POLE 30A	3 POLE 40A	3 POLE 100A	3 POLE 150A	SPACE 1P	SPACE 3P	NOTES
DFH14-EQ1-P4	225A		SURFACE	65KAIC	42															1			
DFH11-EQ1-P4	225A		SURFACE	65KAIC	42															1			
DFH9-EQ1-P4	225A		SURFACE	65KAIC	42															1			
DFH7-EQ1-P4	225A		SURFACE	65KAIC	42															1			
DFH5-EQ1-P4	225A		SURFACE	65KAIC	42															1			
DFH3-EQ1-P4	225A		SURFACE	65KAIC	42															1			
DFH1-EQ1-P4	225A		SURFACE	65KAIC	42															1			
DFHP2-EQ1-P4	225A		SURFACE	65KAIC	42															1			
DFHP4-EQ1-P4	225A		SURFACE	65KAIC	42															1			
DFH4-EQP-P4-A		225A	SURFACE	65KAIC	84																		
DFH4-EQP-P4-B		225A	SURFACE	65KAIC	84																		
DFH4-EQP-P4-C		225A	SURFACE	65KAIC	84																		
DFH4-EQP-P4-D		225A	SURFACE	65KAIC	84																		
DFH4-EQP-P4-E		225A	SURFACE	65KAIC	42																		
DFH4-EQP-P4-F		225A	SURFACE	65KAIC	42																		
DFH3-UPSIM-PIM2	150A		SURFACE	65KAIC	42																		

SCHEDULE OF PANELBOARDS (LIFE SAFTY)

(208/120V, 3 PHASE, 4 WIRE)

PANEL	MAINS MCB	MAINS MLO	MOUNTING	C.B. IC	TOTAL POLES	1 POLE 20A	1 POLE 30A	1 POLE 40A	1 POLE 50A	1 POLE 60A	2 POLE 20A	2 POLE 30A	2 POLE 40A	2 POLE 50A	2 POLE 60A	3 POLE 20A	3 POLE 30A	3 POLE 40A	3 POLE 100A	3 POLE 150A	SPACE 1P	SPACE 3P	NOTES
DFHM2-LS-P2	150A		SURFACE	22KAIC	84															4			
DFH15-LS-P2	150A		SURFACE	22KAIC	42																		
DFH12-LS-P2	150A		SURFACE	22KAIC	42																		
DFH10-LS-P2	150A		SURFACE	22KAIC	42																		
DFH8-LS-P2	150A		SURFACE	22KAIC	42																		
DFH6-LS-P2	150A		SURFACE	22KAIC	42																		
DFH4-LS-P2	150A		SURFACE	22KAIC	84																		
DFH2-LS-P2	150A		SURFACE	22KAIC	42																		
DFHP1-LS-P2	150A		SURFACE	22KAIC	42																		
DFHP3-LS-P2	150A		SURFACE	22KAIC	42																		
DFHM3-LS-P2-A	150A		SURFACE	22KAIC	42																		
DFHM3-LS-P2-B	150A		SURFACE	22KAIC	42																		
DFHM3-LS-P2-C	150A		SURFACE	22KAIC	42																		
DFHM3-LS-P2-D	150A		SURFACE	22KAIC	42																		

SCHEDULE OF PANELBOARDS (LIFESAFTY)

(480/277V, 3 PHASE, 4 WIRE)

PANEL	MAINS MCB	MAINS MLO	MOUNTING	C.B. IC	TOTAL POLES	1 POLE 20A	1 POLE 30A	1 POLE 40A	1 POLE 50A	1 POLE 60A	2 POLE 20A	2 POLE 30A	2 POLE 40A	2 POLE 50A	2 POLE 60A	3 POLE 20A	3 POLE 30A	3 POLE 40A	3 POLE 80A	3 POLE 100A	SPACE 1P	SPACE 3P	NOTES
DFHM2-LS-P4	400A		SURFACE	65KAIC	42	39													1				
DFH15-LS-P4	150A		SURFACE	65KAIC	42	39													1				
DFH12-LS-P4	150A		SURFACE	65KAIC	42	39													1				
DFH10-LS-P4	150A		SURFACE	65KAIC	42	39													1				
DFH8-LS-P4	150A		SURFACE	65KAIC	42	39													1				
DFH6-LS-P4	150A		SURFACE	65KAIC	42	39													1				
DFH4-LS-P4	150A		SURFACE	65KAIC	42	39													1				
DFH2-LS-P4	150A		SURFACE	65KAIC	42	39													1				
DFH1-LS-P4	150A		SURFACE	65KAIC	42	39													1				
DFHP1-LS-P4	150A		SURFACE	65KAIC	42	39																	
DFHP3-LS-P4	150A		SURFACE	65KAIC	42											10					4		

Architect
Payette Associates Inc.
290 Congress Street, Fifth Floor
Boston, MA 02210-1005
Tel: 617-895-1000
Fax: 617-895-1002

PAYETTE

Civil and Transportation Engineer
Vanasse Hangen Brustlin, Inc.
99 High Street, 13th Flr.
Boston, MA 02110
Tel: 617-607-2971
www.vhb.com

Landscape Architect
Michael Van Valkenburgh Associates, Inc.
231 Concord Avenue
Cambridge, MA 02138
Tel: 617-864-2076
www.mvvainc.com

Structural Engineer
LeMessurier
1380 Soldiers Field Road
Boston, MA 02135
Tel: 617-868-1200
www.lemessurier.com

Structural Engineer (Dana-Mayer)
Simon Design Engineering
49 Walnut Park, Bldg. #2
Wellesley, MA 02481
Tel: 781-237-2226
www.sde-us.com

MEPFP Tel/Data Engineer and Lighting
Bard, Rao + Athanas Consulting Engineers
10 Guest Street, 4th Flr.
Boston, MA 02135
Tel: 617-254-0016
www.brplusa.com

Vertical Transportation and Materials Management
St. Onge
1400 Williams Road
York, PA 17402
Tel: 717-840-8181
www.stonge.com

Life Safety Consultant
Code Red Consultants
123 Turnpike Road, Suite 320
Southborough, MA 01772
Tel: 617-500-7633
www.coderedconsultants.com

Medical Equipment
C/W Design Group
57 Bedford Street, Suite 207
Lexington, MA 02420
Tel: 781-274-7275
www.cwdesigngroup.com

Hardware Consultant
Allegion
77 Wexford Street
Needham Heights, MA 02494
Tel: 781-453-5300
www.allegion.com

Wind/Air Entrainment Consultant
RWDI
600 Southgate Drive
Guelph, Ontario, N1G 4P6
519-823-1311
https://rwdi.com

Building Facade Consultant
Studio NYL 129
Kingston Street, Ground Floor
Boston, MA 02111
Tel: 303-558-3145
www.studionyl.com

Building Enclosure Consultant
Simpson Gumpertz & Heger
480 Totten Pond Road
Waltham, MA 02451
Tel: 617-907-9000
www.sgh.com

Parking Consultant
Walker Consultants
1075 Main St., Suite 410
Waltham, MA 02451
Tel: 617-350-5040
www.walkerconsultants.com

Acoustics Engineer
Acentech
33 Moulton Street
Cambridge, MA 02138
Tel: 617-499-8031
www.acentech.com

Food Services Consultant
Kaizen
1525 Cornwall Road
Unit 14
Oakville, ON L6J 0B2
Tel: 905-338-3222
www.kaizenfood.com

Radiation Shielding Consultant
Nelco/Trapani
2 Burlington Woods Drive, Suite 300
Burlington, MA 01803
Tel: 781-331-0429
www.nelcoworldwide.com

RF Shielding Consultant
PDC Facilities, Inc.
700 Walnut Ridge Drive
Hartland, WI 53029
Tel: 262-367-7944
www.pdcbiz.com

Issues

Number	Date	Description
00	10-30-25	FAÇADE AND INFRASTRUCTURE PACKAGE

Revisions

Number	Date	Description

NOT FOR CONSTRUCTION

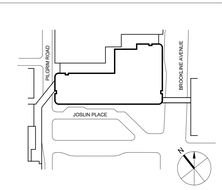

Dana-Farber Cancer Institute | Beth Israel Lahey Health Beth Israel Deaconess Medical Center

FUTURE CANCER HOSPITAL
1 JOSLIN PLACE, BOSTON MA 02115

Drawing Scale: N.T.S.
Project Number: 17000.00
Date Issued: 10/30/2025

ELECTRICAL SCHEDULE OF PANEL BOARD #2

E7.502

©2025 Payette Associates Inc.

Autodesk Docs://DFC-Cancer_Hosp/17000.00-Cancer Hospital-EL-EC-EQ2.rvt
10/30/2025 2:53:31 PM